

Name Julian J. BussagangService No. 39Address 43 Peacock Farm Road43 Peacock Farm Rd.Location 43 Peacock Farm Road

Kind of Pipe

Size 6"Size of Main 8"~~Repair~~ New ServiceWO # 8628Location JUN 29 1964


Date	Material	Amount	Total	Date	Amount
5-28-64	Labor	62.34		4-2-64	425.00
5-29-64	"	52.99	115.33		
	10% O.H.	11.53	126.86	6-24-64	76.19
	73' 6" Transite pipe @.82		59.86		378.81
	1 11 $\frac{1}{2}$ " Transite Bend		4.09		
	1 Cesspool Cover & Frame		10.50		
	300 Sewer Brick @4.20 per 100		12.60		
	2 bags. Cement @1.50		3.00		
	1 ton sand		1.10		
	6 yds. Loan @2.00		12.00		
	6 hrs. Tom Shovel @6.50		39.00		16.3 feet 6" A.C.
	4 hrs. Trucking @3.00		12.00		installed by contractor
	Previous Charge		97.80		@ 6.00 per foot
			378.81		97.80

DATE _____

TOWN OF LEXINGTON — BOARD OF PUBLIC WORKS

SEWER DIVISION

Sketch of Service Here **43**

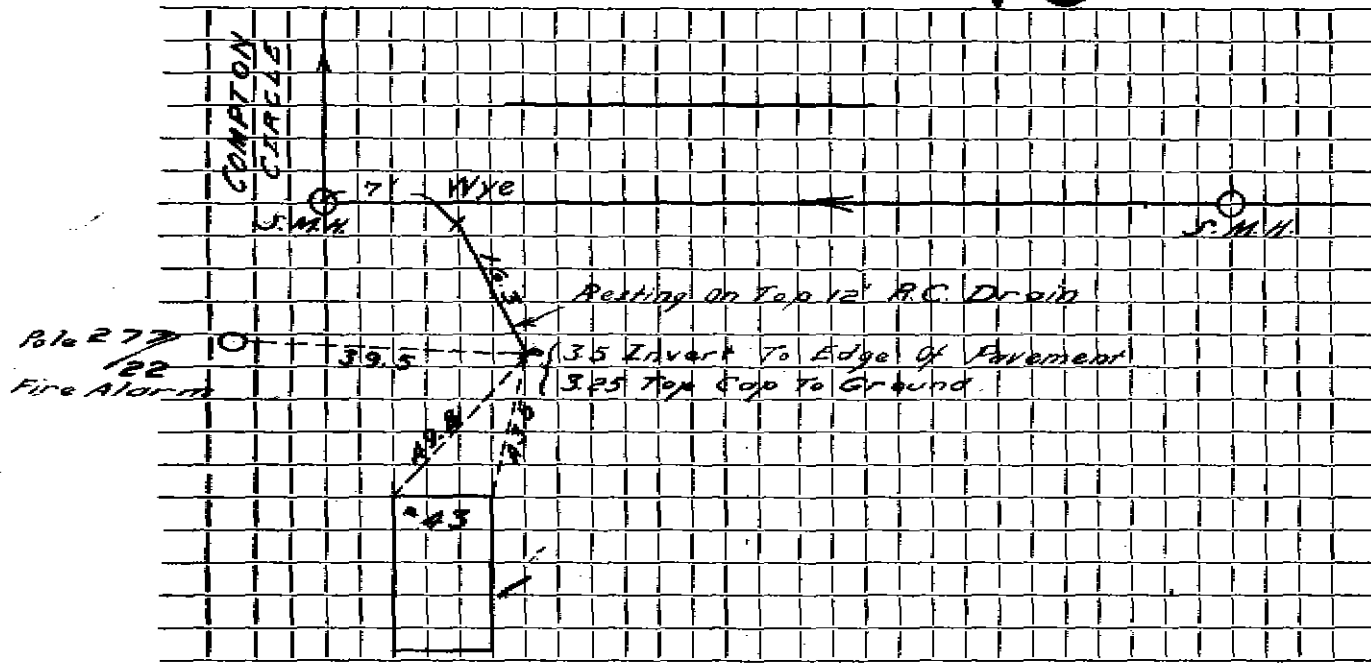

Connection made in Street. Work completed

Remarks: