

Name **Paul D. Krensky**Service No. **177**Address **45 Peacock Farm Road****45 Peacock Farm Rd.**Location **45 Peacock Farm Road**

Kind of Pipe

Size **6"**Size of Main **8"**~~REPAIR/RENEWAL~~ **New Service**WO # **8302**

Location

JUN 29 1964

Date	Material	Amount	Total	Date	Amount
21-63 20-63	Labor	86.40		11-12-63	350.00
	10% O.H.	8.64	95.04	3-10-65	5.63
	95' 6" Transite pipe @.82		77.90		355.63
	1 bag Cement		1.50		
	1 22½° Transite Bend		4.09		
	2 11½° Transite Bends @4.09		8.18		
	1 22½° Transite Elbow		2.35		
	1 11½° Transite Elbow		2.35		
	1 6" Duplex Adapter		1.92		21.8 feet 6" A.C.
	3 hrs. Town Shovel @6.50		19.50		installed by contractor
	3 hrs. Trucking @3.00		9.00		@ 6.00 per foot
	1 hr. Trailer @3.00		3.00	12-7-73	130.80
	Previous Charge		130.80		563
			355.63		
					Bill sent 563


DATE _____

TOWN OF LEXINGTON — BOARD OF PUBLIC WORKS

SEWER DIVISION

Sketch of Service Here

45

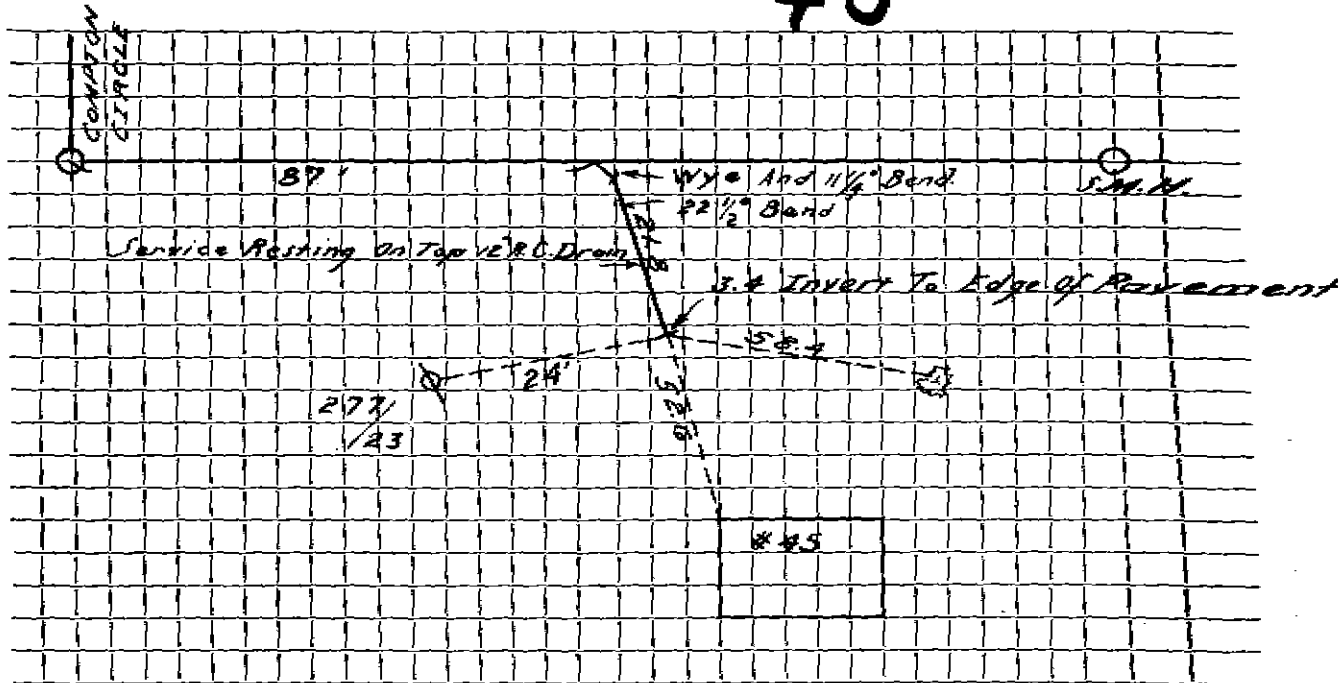

Connection made in Street. Work completed

Remarks:

.....

.....