

Name **Helen S. Demores**Service No. **16**Address **46 Peacock Farm Road****46 Peacock Farm Rd.**Location **46 Peacock Farm Road**

Kind of Pipe

Size **6"**Size of Main **8"**~~REPLACEMENT~~ **New Service****WOFF 8579**Location **Comm 5-18-64**

| Date   | Material                       | Amount | Total         | Date    | Amount                  |
|--------|--------------------------------|--------|---------------|---------|-------------------------|
| -13-64 | Previous Charge                |        | 138.00        |         |                         |
|        | Labor 43.54                    |        |               | 3-6-64  | Deposit 400.00          |
| -23-64 | " 80.43                        |        |               | 5-28-64 | Paid 19.46              |
| -24-64 | " 18.56                        | 142.63 |               |         | 719.46                  |
|        | 10% O.H.                       | 14.26  | 156.89        |         |                         |
|        | 38' 6" Transite pipe @.82      |        | 31.16         |         |                         |
|        | 14' 6" C.I. Water pipe @1.46   |        | 20.44         |         |                         |
|        | 2 11 1/2° Transite Elbow @2.35 |        | 4.70          | 6-12-63 | Rests Respond + Measure |
|        | 2 11 1/2° Transite Bends @4.09 |        | 8.18          |         |                         |
|        | 1 22 1/2° Transite Bend        |        | 4.09          |         | 23.0 feet 6" A.C.       |
|        | 2 6" Adapter @1.62             |        | 3.24          |         | installed by contractor |
|        | 1 12" Transite Nipple          |        | 1.21          |         | @ 6.00 per foot         |
|        | 1 bag Cement                   |        | 1.55          |         | 138.00                  |
|        | 4 yards Loam @3.00             |        | 12.00         |         |                         |
|        | 2 hrs. Town Shovel @6.50       |        | 13.00         |         |                         |
|        | 4 hrs. Trucking @3.00          |        | 12.00         |         |                         |
|        | 2 hrs. Loader @4.00            |        | 8.00          |         |                         |
|        | 1 hr. Compressor @5.00         |        | 5.00          |         |                         |
|        |                                |        | <u>419.46</u> |         |                         |


DATE \_\_\_\_\_

TOWN OF LEXINGTON — BOARD OF PUBLIC WORKS

SEWER DIVISION

Sketch of Service Here

46

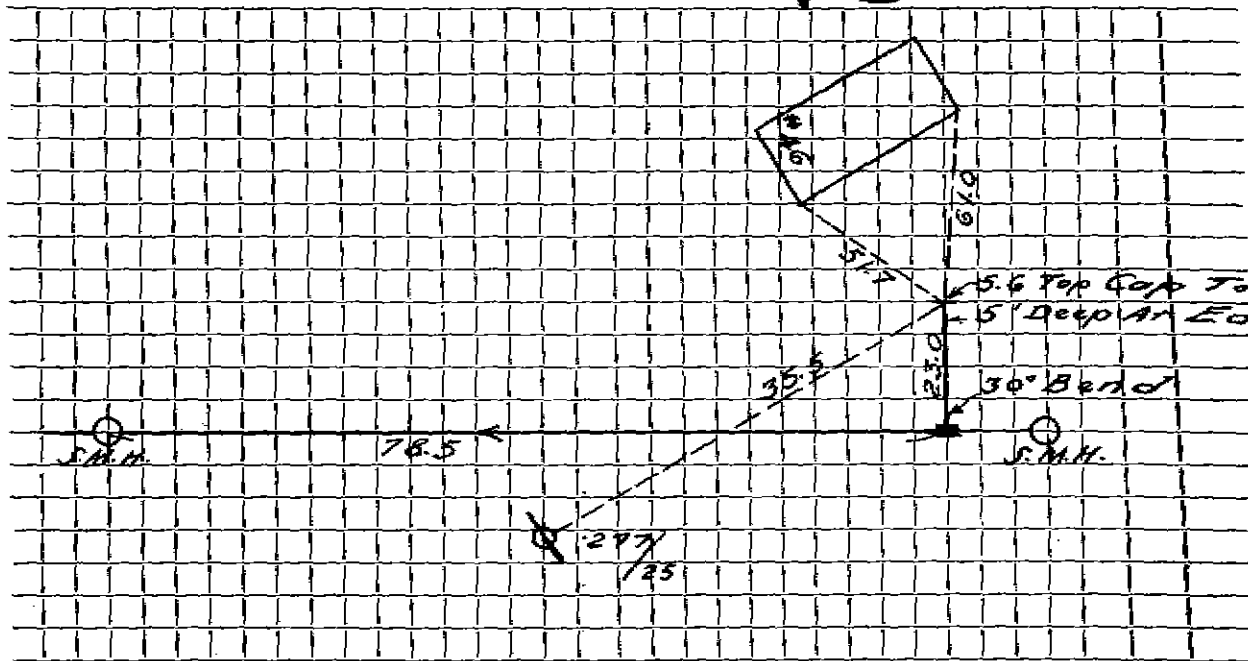

Connection made in ..... Street. Work completed .....

Remarks: .....

.....

.....