

Name **Paul J. Harris**

Service No. 168

Address 47 Peacock Farm Road

47 Peacock Farm Rd.

Location 47 Peacock Farm Road

Kind of Pipe

Size 6"

Size of Main 8"

~~Revised Estimate~~ - New Service

Work 8288


Location Comm 5-18-64

Date	Material	Amount	Total	Date	Amount
1-21-64	Labor	68.06		11-6-63	425.00
	10% O.H.	6.81	76.87	5-18-64	104.79
	86' 6" Transite pipe @.82		70.52		322.21
	1 bag Cement		1.55		
	2 22 1/2° Transite Bend @4.09		8.18		
	1 11 1/2° Transite Bend		4.09		
	2 11 1/2° Transite Elbow @2.35		4.70		
	3 hrs. Town Shovel @6.50		19.50		
	2 hrs. Trucking @3.00		6.00		
	Previous charge		130.80		
			322.21		
				21.8 feet 6" A.C. installed by contractor @ 6.00 per foot	130.80

TOWN OF LEXINGTON — BOARD OF PUBLIC WORKS  
 DATE \_\_\_\_\_

SEWER DIVISION

Sketch of Service Here **47**

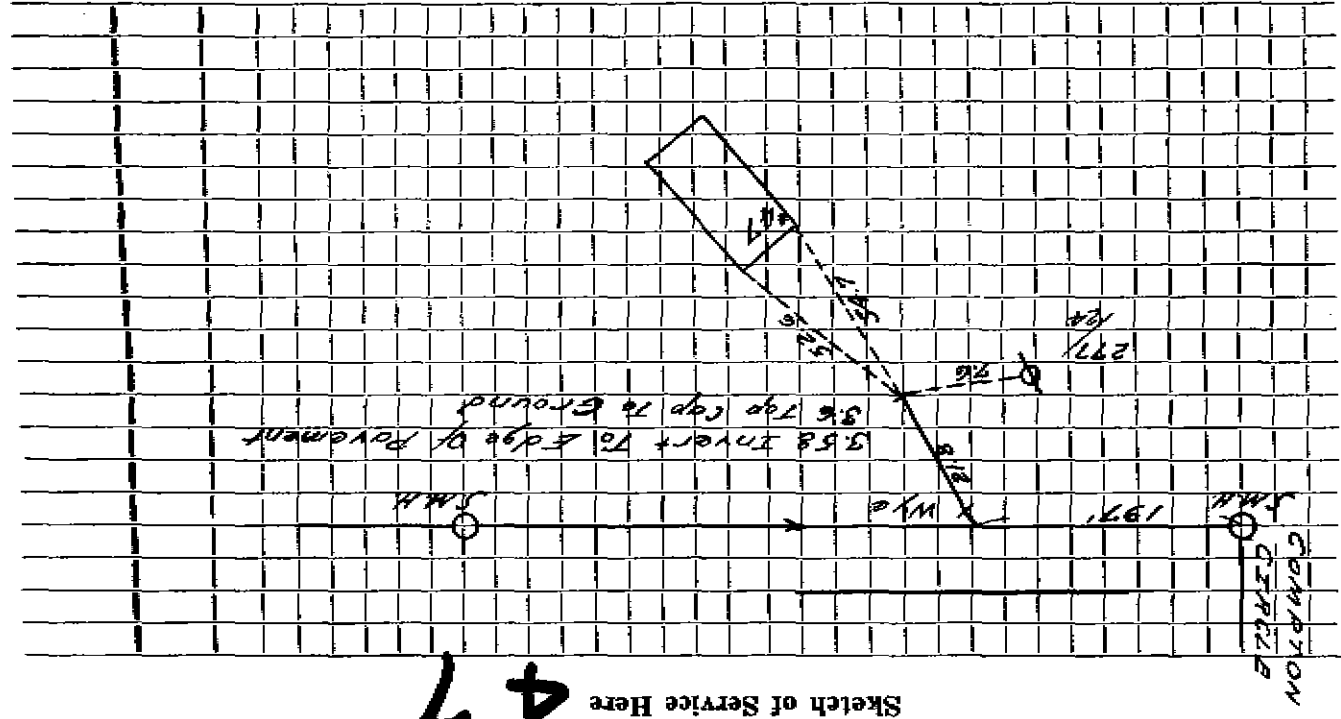

Connection made in \_\_\_\_\_ Street. Work completed \_\_\_\_\_

Remarks: \_\_\_\_\_