

Name Robert Loss

Service No.

Address 51 Peacock Farm Road

51 Peacock Farm Rd.

Location

Kind of Pipe

Size 6"

Size of Main 8"

~~Repair~~ Renewal ~~New~~ ~~Excavation~~ W.O.#1093

Location

Date	Material	Amount	Total	Date		Amount
3/5/58	Labor	40.17				
	10% O.H.	4.02	44.19			
120'	6" Transite pipe @.70		84.00		OUTSIDE	
1	1 1/4" Elbow		2.24	7/16/91	38' 6" PVC	
1	2 1/2" Elbow		2.24		4' 8" PVC	
2	hrs. Trucking		1.50		1 8 x 8 x 6 Tee	
			\$134.17		1 6 x 6 x 6 Wye	
					1 6" Cleanout Cap	
					1 6" CI-PVC Fernco	
					2 8" CI-PVC Fernco	
					24 Yards Graven	


DATE \_\_\_\_\_

TOWN OF LEXINGTON — BOARD OF PUBLIC WORKS

SEWER DIVISION

Sketch of Service Here

51

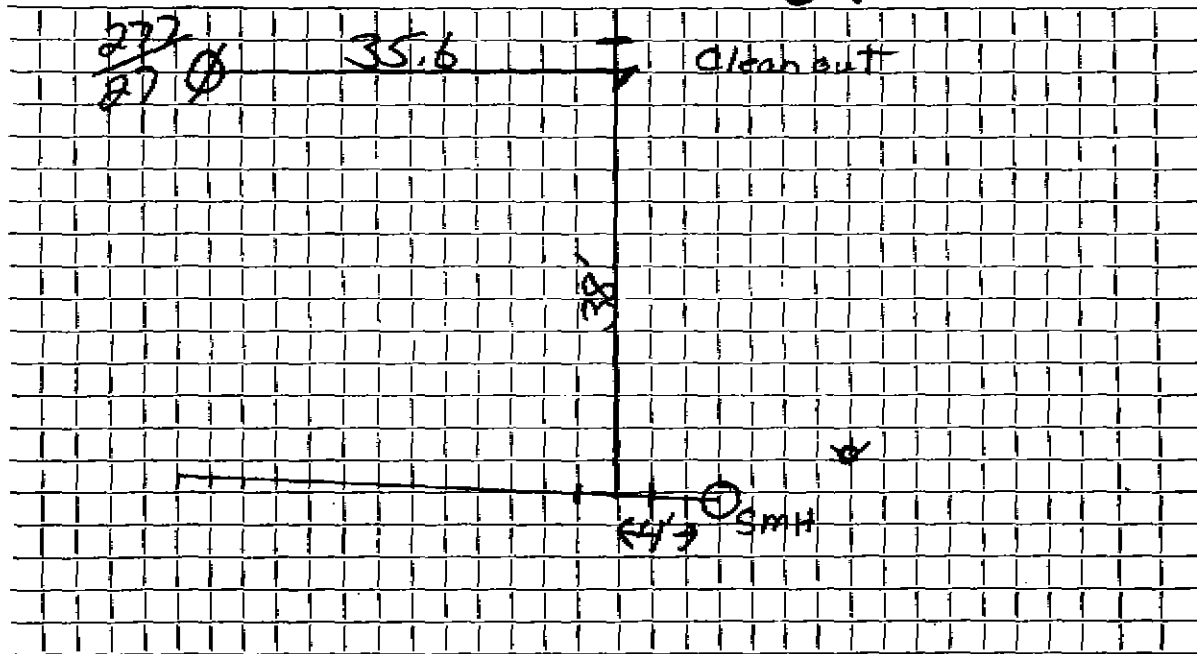

Connection made in ..... Street. Work completed ..... 7-16-91 .....

Remarks: ..... 2' Chimney, 4.6 deep, 4' From Manhole .....  
..... Clean out @ Property Line .....