

Name Philip L. Abrams

Service No. #98

Address 6 Peacock Farm Road

6 Peacock Farm Rd.

Location

Kind of Pipe

Size 6"

Size of Main 8"

~~Repair - Renewal~~ - New Service W.O. #7432Location *Com 10-29-62*


Date	Material	Amount	Total	Date	Amount	
7-30-62	Labor	99.41		6-29-62	Deposit	400 00
3-4-62	"	42.60	142.01	10-29-62	ReFund	100 72
	10% O.H.	14.20	156.21			299 28
104'	6" Transite pipe @82		85.28			
1	22 $\frac{1}{2}$ " Transite Bend		4.09			
1	22 $\frac{1}{2}$ " Transite Elbow		2.35			
1	11 $\frac{1}{2}$ " Transite Elbow		2.35			
2	Hrs. Town Shovel @6.50		13.00			
2	Hrs. Loader @3.00		6.00			
2	Hrs. Trucking @3.00		6.00			
	24X3 Patch		24.00			
			299.28			

DATE \_\_\_\_\_

TOWN OF LEXINGTON — BOARD OF PUBLIC WORKS

SEWER DIVISION

Sketch of Service Here **6**

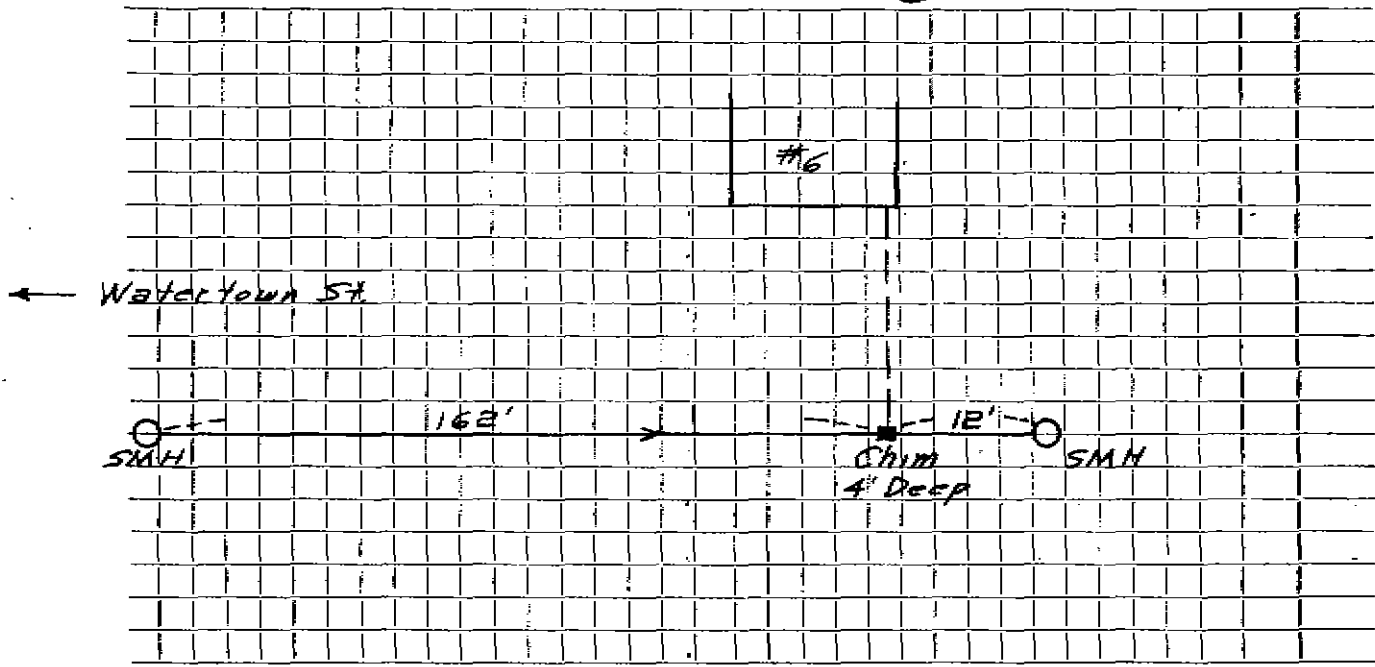

Connection made in ..... Street. Work completed .....

Remarks: .....  
.....  
.....