

Name William A. Binstock

Service No. 77

Address 8 Peacock Farm Road

8 Peacock Farm Rd.

Location

Kind of Pipe

Size 6"

Size of Main 8"

~~Standard Service~~ - New Service W O# 7350

Location Comm 10-1-62

Date	Material	Amount	Total	Date	Amount
28-62	Labor	105.63		6-12-62	300.00
29-62	"	125.65	231.28	6-8-65	91.14
	10% O.H.	23.13	254.41		391.14
	47' 6" Transite pipe @.78		36.66		
	4 1/2 ton 1 1/4" Stone @1.65 ton		7.43		
	1 22 1/2° Transite Elbow		2.35		
	2 22 1/2° Transite Elbows @2.35		4.70		
	1 22 1/2° Transite Bend		4.09		
	4 hrs. Town Shovel @6.50		26.00		
	5 hrs. Trucking @3.00		15.00		
	1 hr. Trailer @3.00		3.00		
	16 x 7 Patch		37.50		
			391.14		


Bill Sent 9/14

DATE _____

TOWN OF LEXINGTON — BOARD OF PUBLIC WORKS
SEWER DIVISION

Sketch of Service Here

8

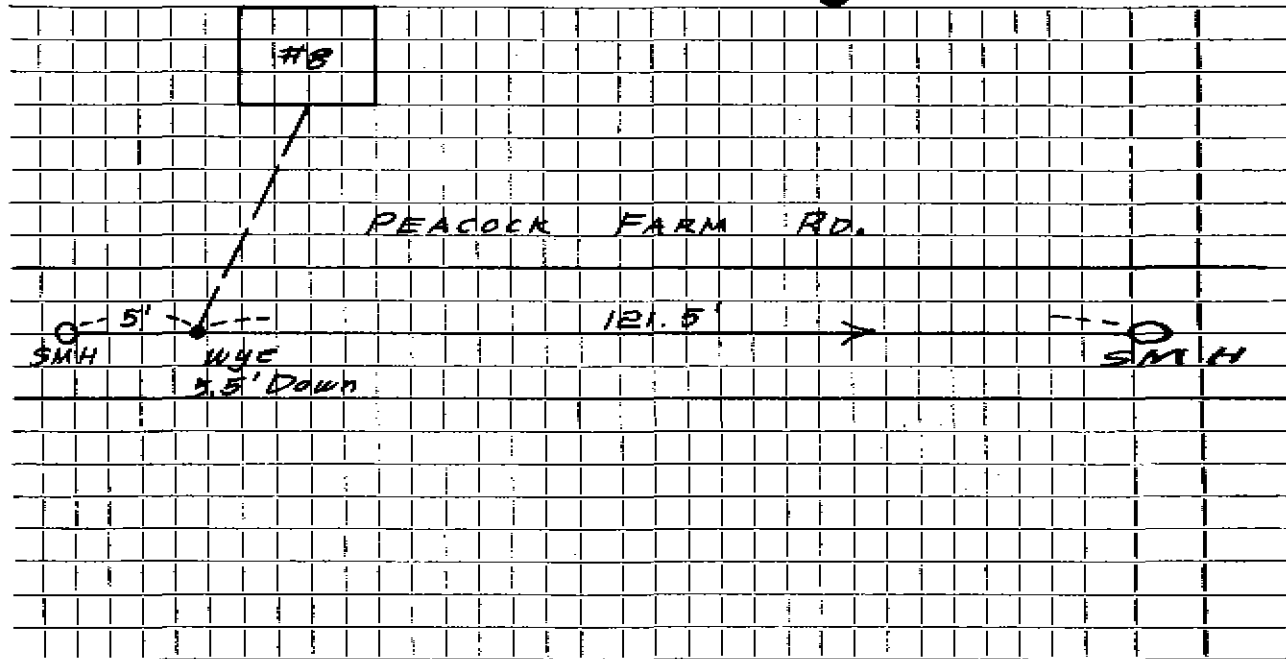

Connection made in Street. Work completed

Remarks:
.....
.....