



TOWN OF LEXINGTON — BOARD OF PUBLIC WORKS


SEWER DIVISION

DATE

Oct 1983

Sketch of Service Here

9

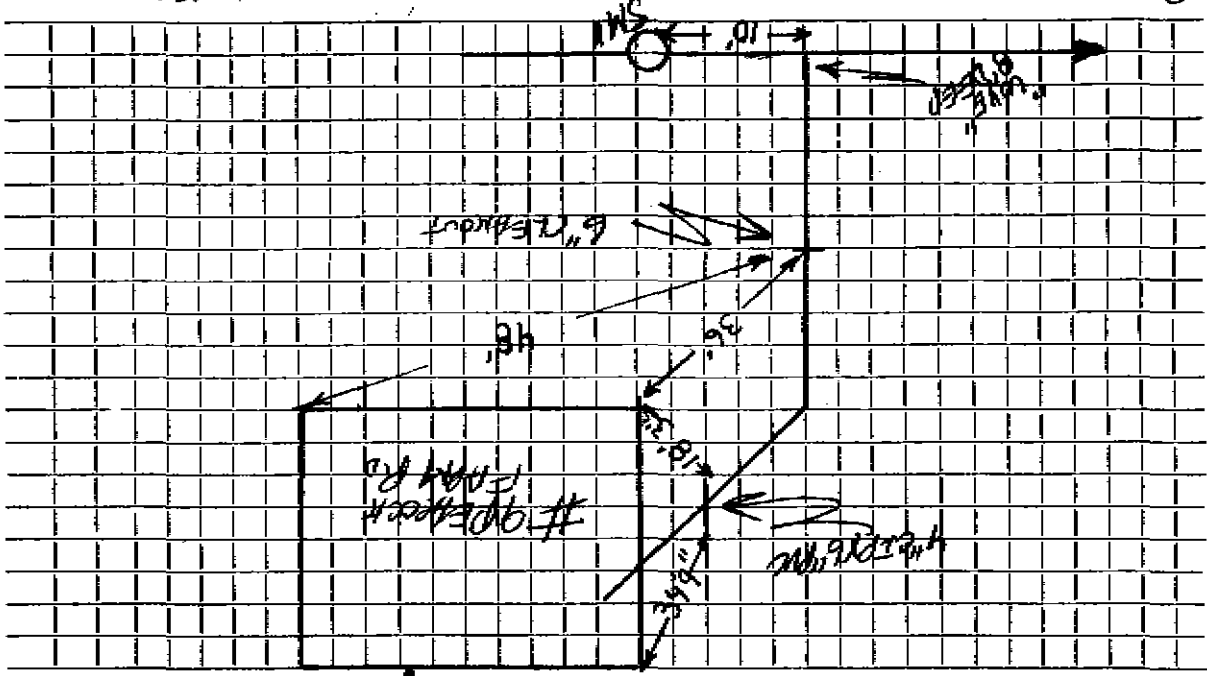

Work completed . Oct 1983

Street

DEBBECH FARM RD

Connection made in

Remarks: