


DATE _____

TOWN OF LEXINGTON — BOARD OF PUBLIC WORKS

SEWER DIVISION

Sketch of Service Here

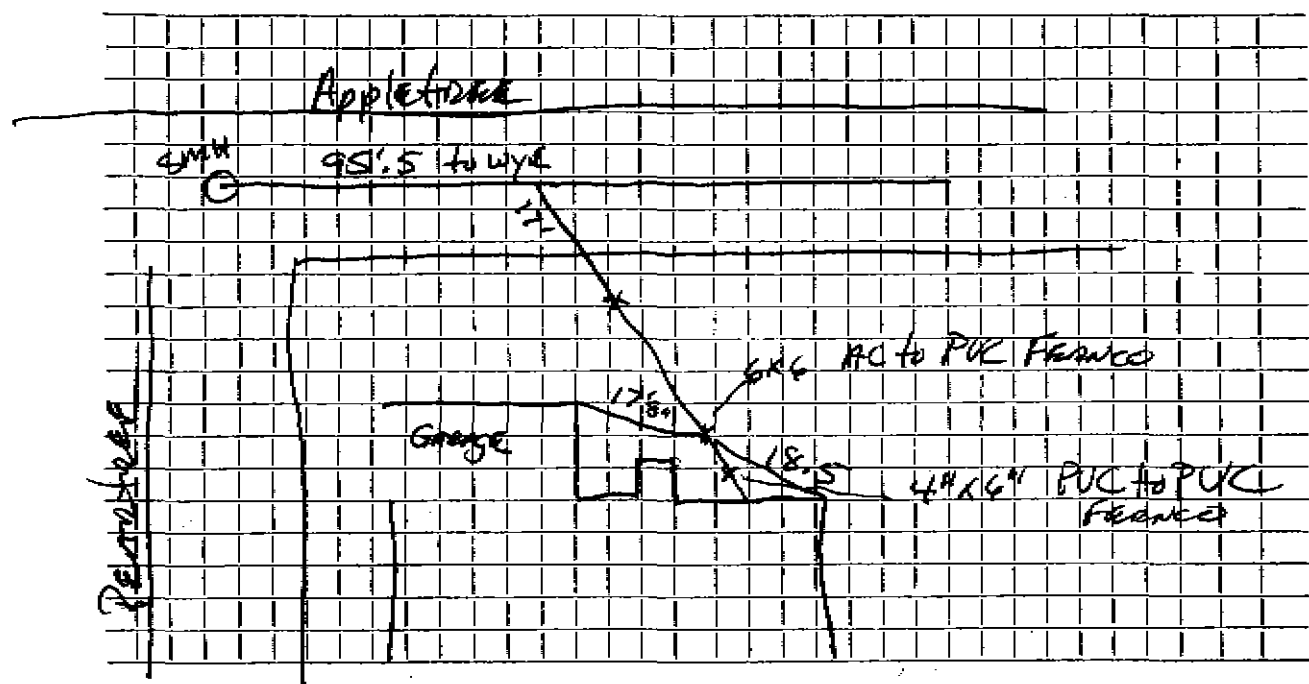

Connection made in Street. Work completed

Remarks: 2-17-99 New house connected to Appletree on existing
TRANSIT SERVICE