


DATE 11-12-08

TOWN OF LEXINGTON — BOARD OF PUBLIC WORKS
SEWER DIVISION

Sketch of Service Here
1 REAR TREE

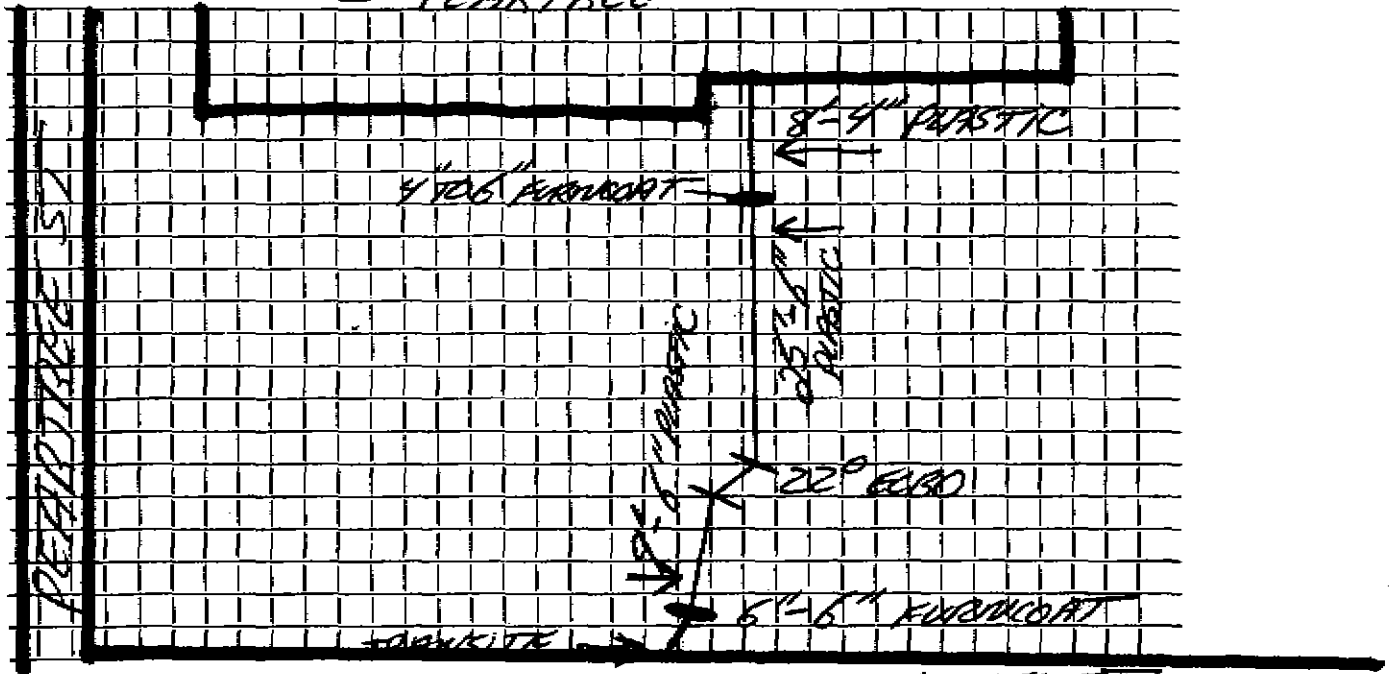

Connection made in Street Work completed LOWELL ST

Remarks:
.....
.....