




DATE 4/8/85

TOWN OF LEXINGTON — BOARD OF PUBLIC WORKS  
SEWER DIVISION

Sketch of Service Here **10**

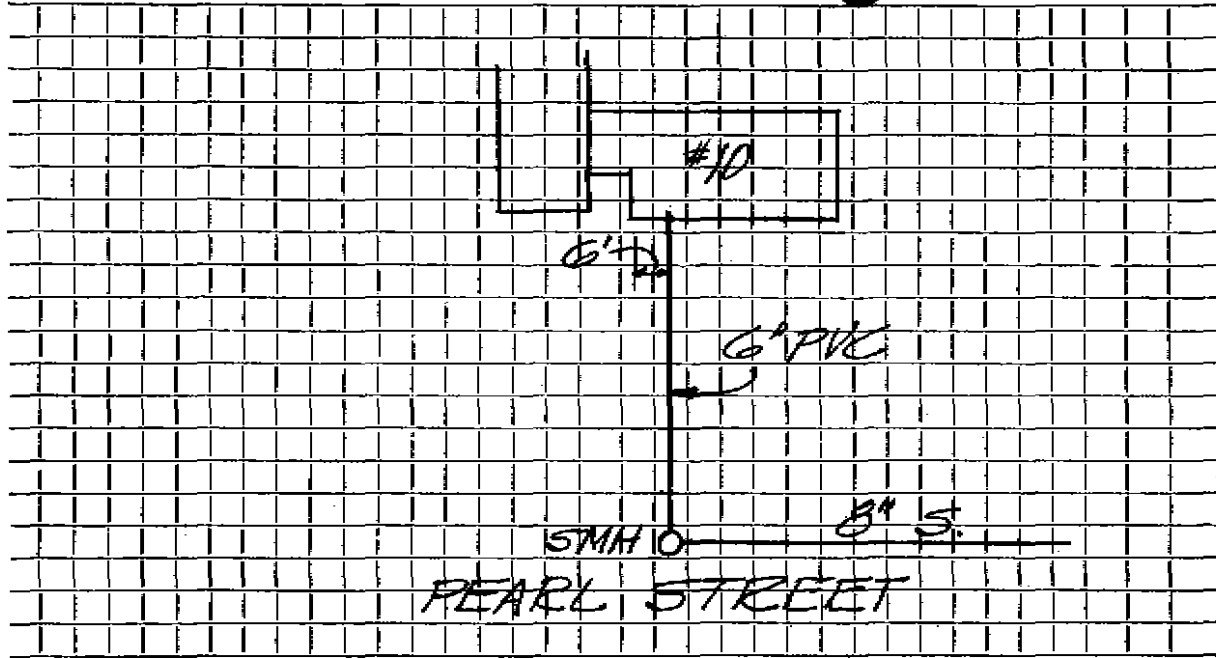

Connection made in Pearl Street. Work completed .....

Remarks: Unaccepted Street Built By R. Mabary - All Work Done By Owner Nov. 1984  
.....  
.....