

Name

Service No.

Address ¹⁶ Pearl Street

16 Pearl Street

Location Lot 152

Kind of Pipe

Size 6"

Size of Main 8"

Repair—Renewal—New Service

Location

Date	Material	Amount	Total	Date	Amount
	22' 6" V.C. Pipe @ 3.00		66 00		
	Installed by contractor				
	Bill owner when connected				
	22' Pipe				
	Labor				

TOWN OF LEXINGTON—DEPT. OF PUBLIC WORKS
SEWER DIVISION

DATE.....

NO.

The undersigned applies for the construction of a particular sewer connecting No.....
Street and hereby agrees to comply with the Rules and Regulations governing the construction and use of Particular
Sewers, as now or at any future time established by the Board of Selectmen.

Am't of estimate \$.....


Am't Paid \$.....

..... Owner

Sketch of Service Here

16

S.S. For # 16 - LOT # 152

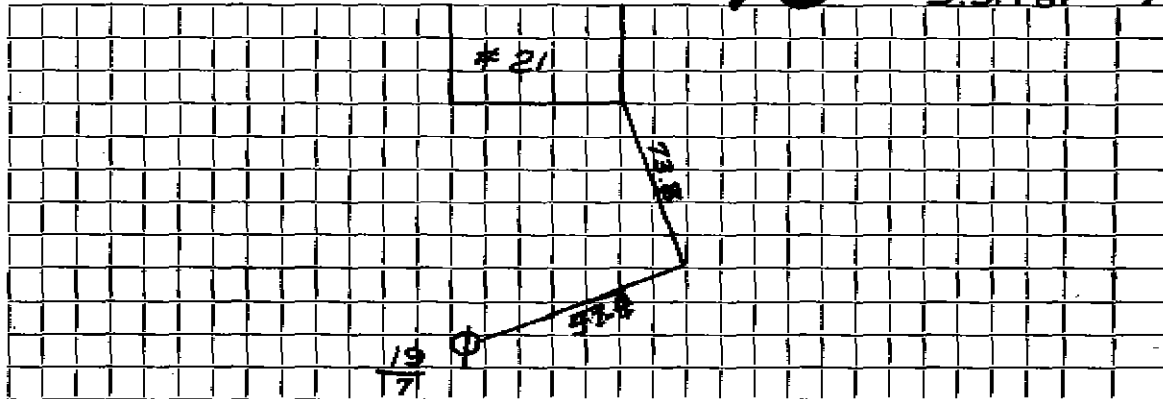

Connection made in..... Street.

Work completed.....19..

Remarks: