

James F. O. Antonelli

Service No. 48

20 Pearl Street

10 Pearl Street

Location

Kind of Pipe

Size 6"

Size of Main 8"


New Service

Location *Case No. 6-19-61*

Date	Material	Amount	Total	Date	Amount
5-17-61	Labor	61.11		5-15-61	Deposit
61	10% O.H.	6.11	67.22	6-19-61	Refund
64	6" trench pipe @.78		47.58		
104	TOB 1 1/2 stone @1.50		9.75		
	TOB Bank Gravel @.85		8.92		
3	TOWNS Sheval @6.50		119.50		
2	TRUCKING @300		6.00		
			158.97		
				12-20-61	S.D.
				5-15-62	S.D. - Main 10' High Chop
				8-26-92	Main Plugged 4' from M.H.

**TOWN OF LEXINGTON — BOARD OF PUBLIC WORKS**  
**SEWER DIVISION**  
DATE \_\_\_\_\_

Sketch of Service Here

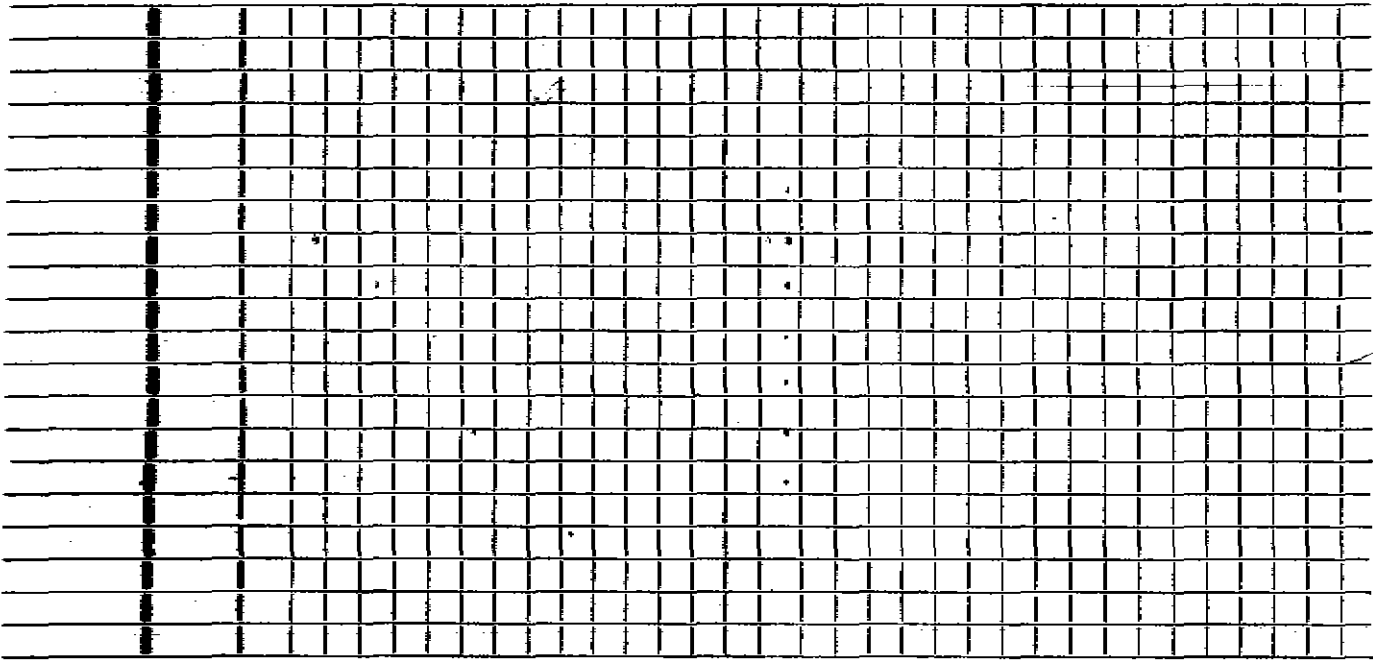

Work completed

Street

Connection made in

Remarks: