

Name Leonard Colwell

Service No. 95

Address 23 Pearl Street

23 Pearl Street

Location Lot # 131-132

Kind of Pipe

Size 6"

Size of Main 8"

Repair—Renewal—New Service Russell E. Sibley 734

Location SEP 5 1967

Date	Material	Amount	Total	Date	Amount
	26' 6" V.C. Pipe @ 3.00	3.00	78 00	8-8-67	Deposit
	Installed by contractor			8-8-67	
	Bill owner when connected			26' 6" Transite	
-10-67	30' 6" Transite				
	10' 4" Cast Iron Pipe				
	Labor				

TOWN OF LEXINGTON—DEPT. OF PUBLIC WORKS
SEWER DIVISION

DATE.....

NO.

The undersigned applies for the construction of a particular sewer connecting No.....
Street and hereby agrees to comply with the Rules and Regulations governing the construction and use of Particular
Sewers, as now or at any future time established by the Board of Selectmen.

Am't of estimate \$.....


Am't Paid \$.....

..... Owner

Sketch of Service Here

23

S.S. For # 23

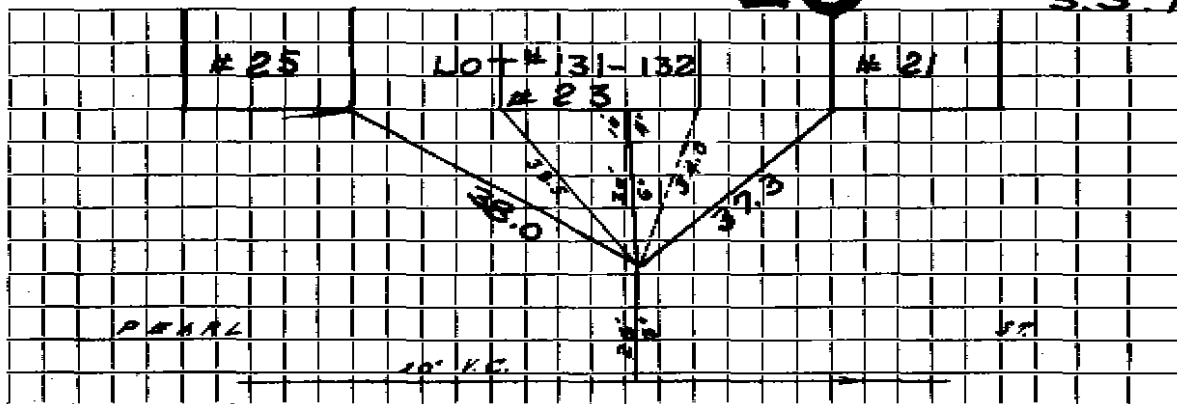

Connection made in..... Street.

Work completed.....19..

Remarks: