

Name Charles Copelitti

Service No. 182

Address 30 Pearl Street ST.

30 Pearl Street

Location VAC. LOT

Kind of Pipe

Size 6"

Size of Main DEC 28 1964

~~Revised~~ New Service Valeri Const. Co. Permit #152

Location DEC 28 1964

Date	Material	Amount	Total	Date	Amount
	29' 6" V.C. Pipe @ 3.00		87 00	11-5-64	Deposit 87 00
	Installed by contractor			11-5-64	
	Bill owner when connected			29' 6" Transite	
L-19-64	41' 6" Transit pipe				
	Labor				

TOWN OF LEXINGTON—DEPT. OF PUBLIC WORKS

SEWER DIVISION

DATE.....

NO.

The undersigned applies for the construction of a particular sewer connecting No.....
 Street and hereby agrees to comply with the Rules and Regulations governing the construction and use of Particular
 Sewers, as now or at any future time established by the Board of Selectmen.


Am't of estimate \$.....

Am't Paid \$.....

..... Owner

Sketch of Service Here **30**

SS. For #30
 Vac. Lot.

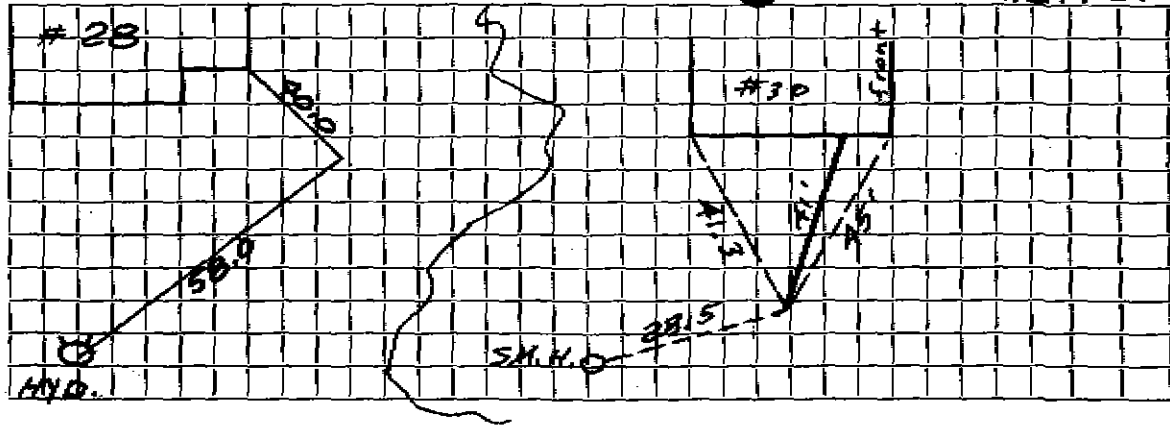

Connection made in..... Street. Work completed.....19..

Remarks: