

Name Pelham Academy-

Service No.

Address #13 Pelham Rd

Location

Kind of Pipe PVC

Size 6

Size of Main 8"

Repair—Renewal—New Service

Location

Date	Material	Amount	Total	Date		Amount
------	----------	--------	-------	------	--	--------

9/19


6" PVC

8' LF

DATE 9/19/19 ^e

TOWN OF LEXINGTON — BOARD OF PUBLIC WORKS
SEWER DIVISION

Sketch of Service Here

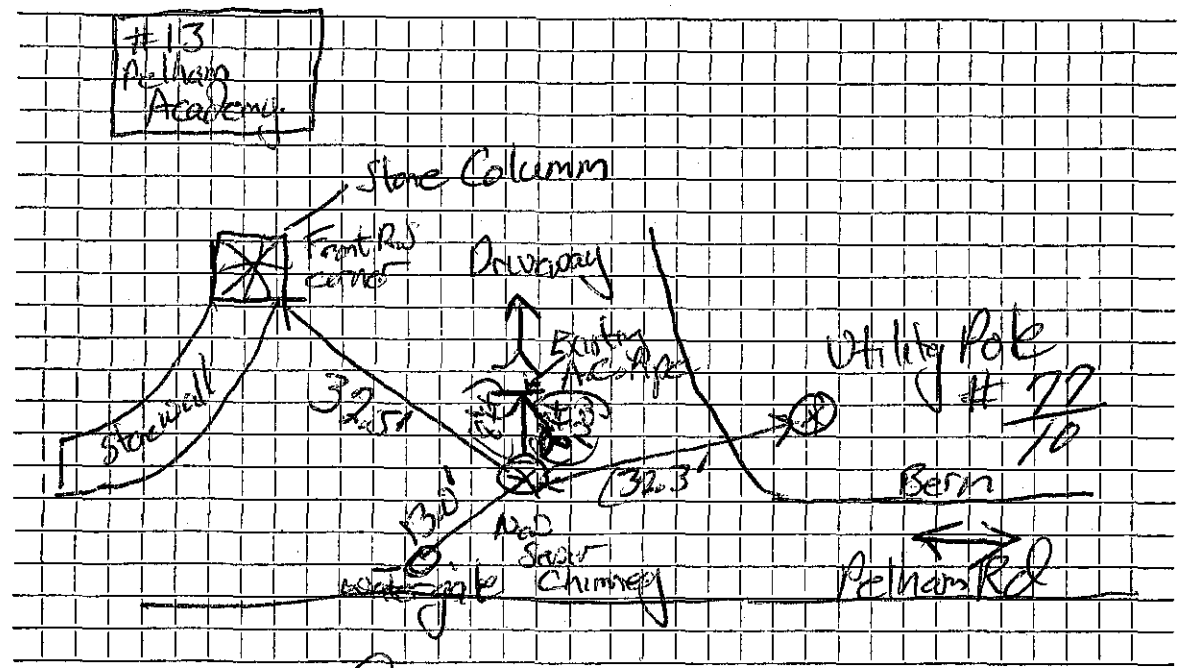

Connection made in Pelham Road Street. Work completed

Remarks: * Note: Approx 8' LF 6\"/>