

Name

# 15 Pelham Rd

Service No.

Address

Location

Kind of Pipe

PVC

Size

6"

Size of Main

8"

Repair—Renewal—

New Service

Location

Date

Material

Amount

Total

Date

Amount

9/19

6" PVC


18' LF

DATE 9/19

TOWN OF LEXINGTON — BOARD OF PUBLIC WORKS

SEWER DIVISION

Sketch of Service Here

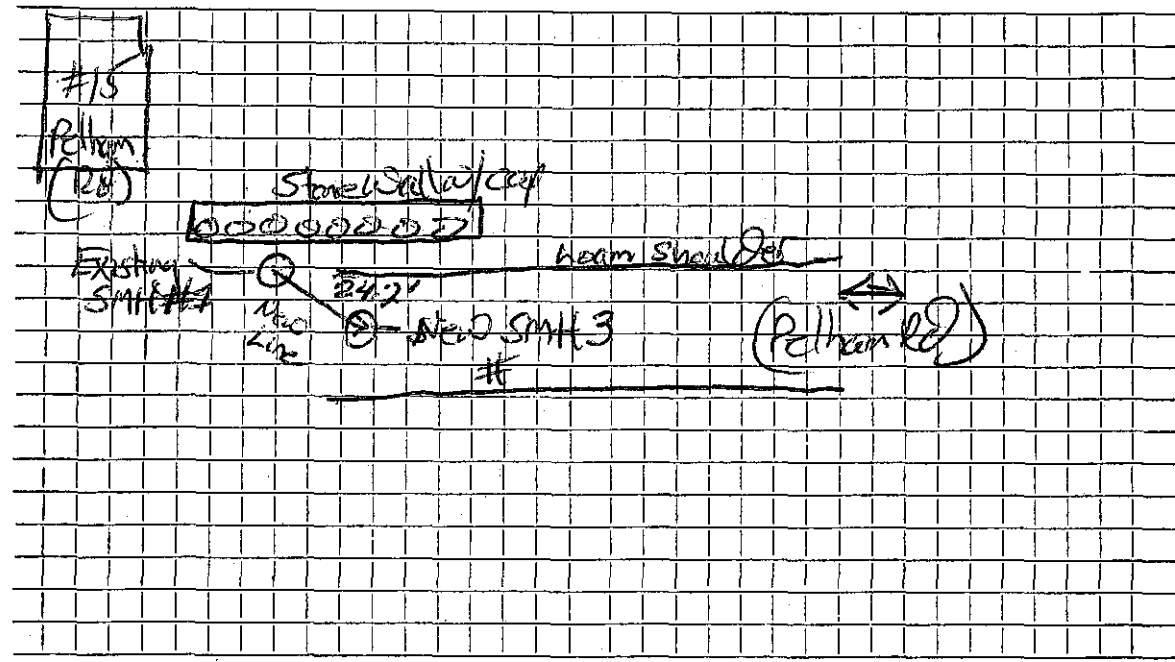

Connection made in Pelham Street. Work completed 9/19

Remarks: .....