

Name

Service No.

Address #5 Pelham Road: Fed off Eliot St

Location

Kind of Pipe

6" PVC

Size

Size of Main

8" PVC

Repair—Renewal—

New Service

Location

Date

Material

Amount

Total

Date

Amount

7/19


6" PVC

21' ft

DATE 7/19 e

TOWN OF LEXINGTON — BOARD OF PUBLIC WORKS
SEWER DIVISION

Sketch of Service Here

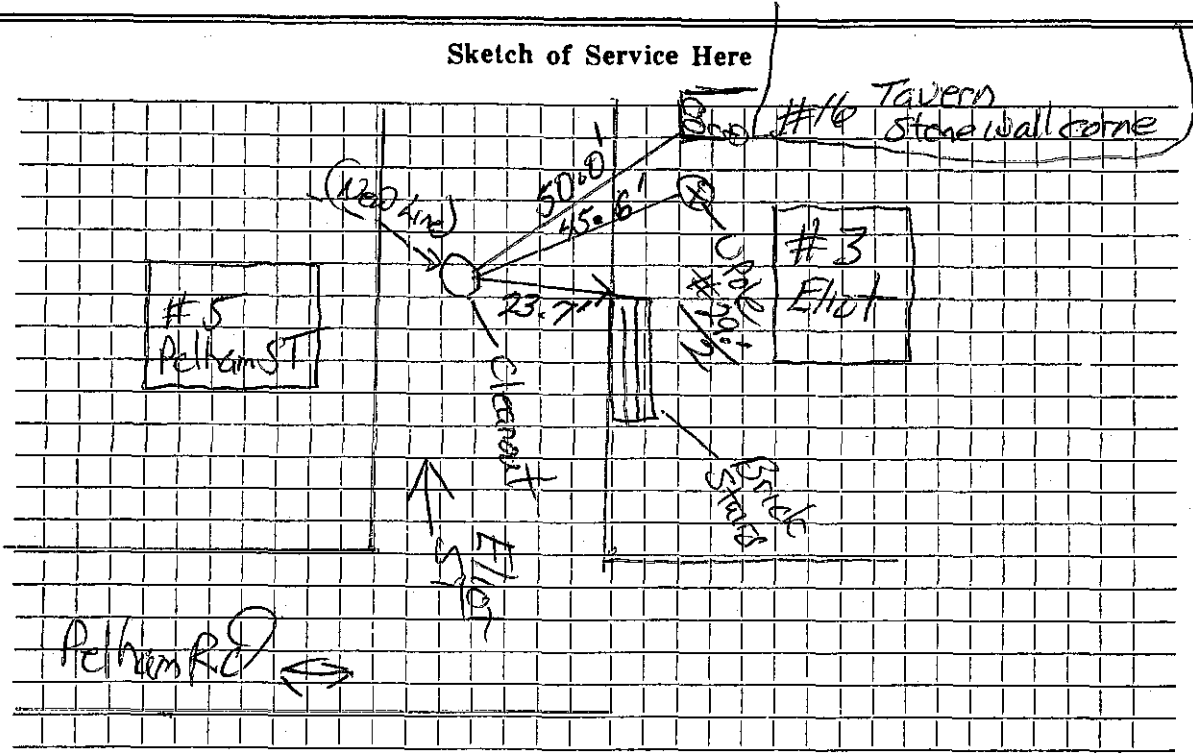

Connection made in Eliot Street. Work completed 7/19

Remarks: #5 Pelham fed off Eliot ST. Store Fabric + Caution Tape on Top