


DATE 8/1/95

TOWN OF LEXINGTON — BOARD OF PUBLIC WORKS
SEWER DIVISION

Sketch of Service Here

15

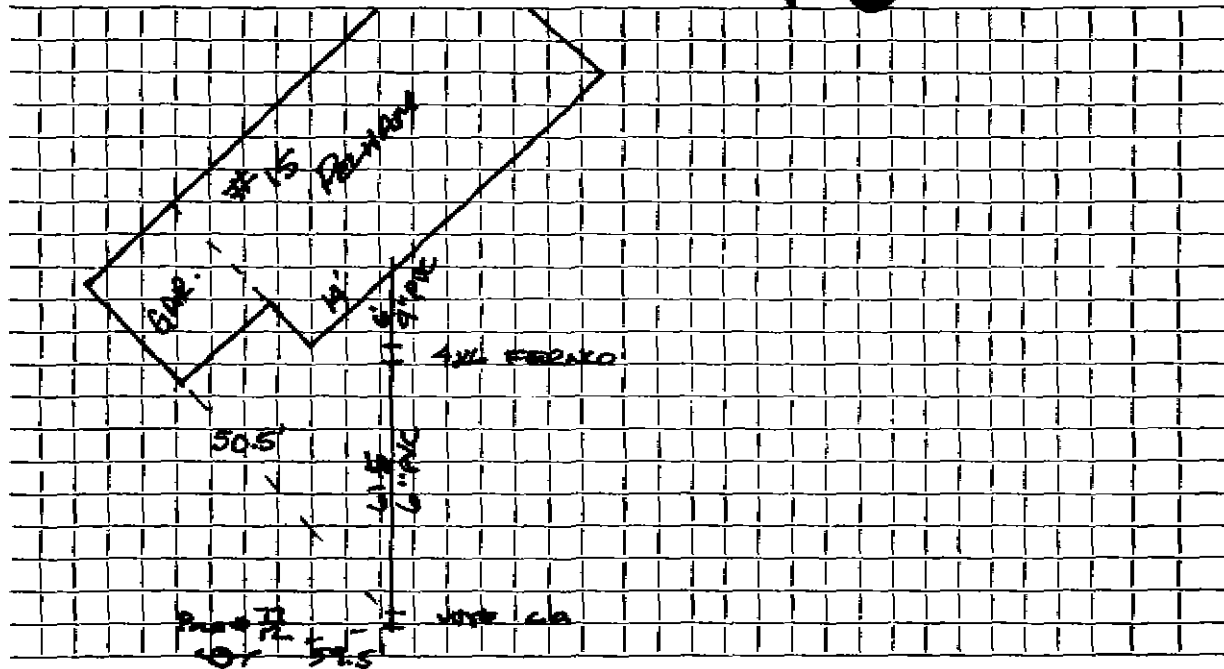

Connection made in PELHAM Street. Work completed

Remarks:

.....

.....