

Service No. 71 P 04

Wm. J. Chester Hutchinson

Address 5 Pelham Road

5 Pelham Road

Kind of Pipe

Size 6"

Size of Main

Rehabilitate Sewer - New Service

Location

Date	Material	Amount	Total	Date	Amount
27-11-25	8.00				
12/22	2 Igths. 30" pipe @	16.00			
	72 1/2" Sewer pipe @ .30	21.60		Oct. 5 1925 - Cash	138.23
	Sulphur & Jute	2.88			
	Trucking	76	41.23		
7/28	130 Hrs. Labor @ .55	71.50			
	3 " " @ .60	1.80			
	1 " Mason	1.25			
	14 " Foreman @ .70	9.80	84.35		
	15% Overhead		12.55		
			138.23		
	Labor				
				10-28-26	Check

TOWN OF LEXINGTON—BOARD OF PUBLIC WORKS
SEWER DIVISION

DATE _____

NO. _____


The undersigned applies for the construction of a particular sewer connecting No. _____
Street and hereby agrees to comply with the Rules and Regulations governing the construction and use of Particular
Sewers, as now or at any future time established by the Board of Selectmen.

Am't. of Estimate \$ _____

Am't. Paid \$ _____

_____ Owner

Sketch of Service Here

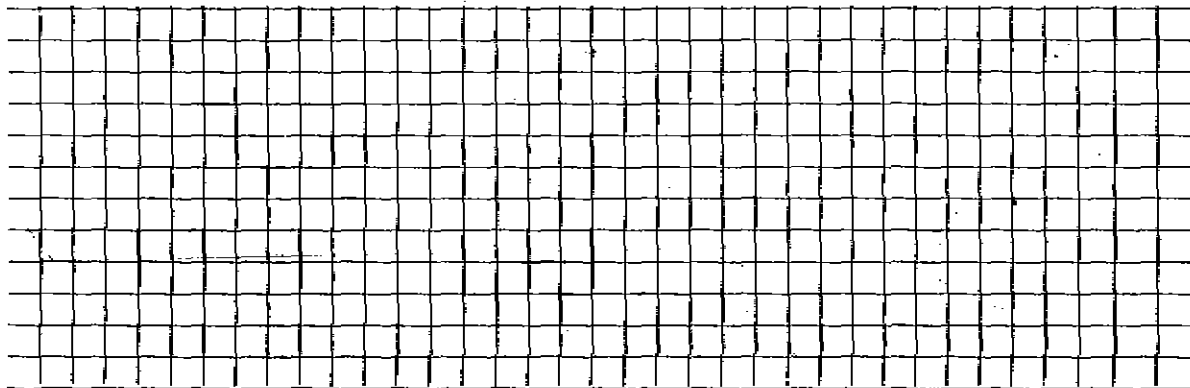

Connection made in _____ Street. Work completed _____ 19

Remarks: