

Name Mrs. Fred A. Ladd, Jr.

Service No. 230

Address #16 PERCY ROAD

16 Percy Road

Location

Kind of Pipe

Size 6"

Size of Main 8"

~~Repair~~ New Service

WO# 7784

Location Com 5-27-63

Date	Material	Amount	Total	Date	Amount
1/27/62	Labor	108.07		12-20-62	Deposit 250.00
1/28/62	"	58.18		2-28-69	Paid 97.32
1/12/68	"	18.36	184.61	2-11-69	Paid 200.00
	10% O.H.	18.46	203.07		547.32
58'	6" Transite Pipe @ .82		250.63		
1	22 1/2° Transite Bend		4.09		
1	11 1/2° Transite Bend		4.09		
1	22 1/2° Transite Elbow		2.35		
1	90° Transite Elbow		4.09		
6	Hrs. Town Shovel @ 6.50		39.00		
6	Hrs. Trucking @ 3.00		18.00		
2	Hrs. Compressor @ 5.00		10.00		
	12 X 3 Patch		12.00		
			547.32		


Bill sent 250.00

DATE _____

TOWN OF LEXINGTON — BOARD OF PUBLIC WORKS
SEWER DIVISION

Sketch of Service Here

16

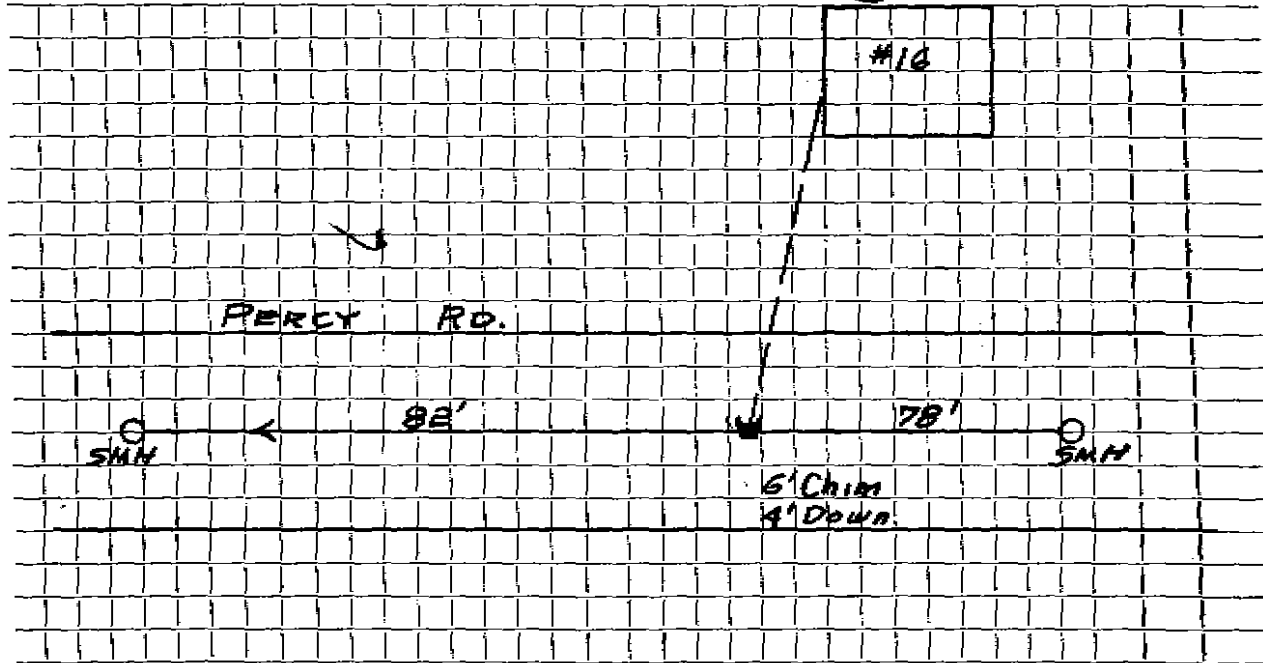

Connection made in Street. Work completed

Remarks:

.....

.....