

Name Phillip Pullen

Service No.

Address 17 Percy Road

17 Percy Road

Location

Kind of Pipe

Size 6"

Size of Main 8"

~~Burntwood~~ - New Service Valeri #4571

Location

Date	Material	Amount	Total	Date	Amount
7/16/86	174' 6" P.V.C.				
3'	4" Cast Iron				
	Saddle				
	90° Elbow				
2	Nye C.O.				
2	27° Bends				
1	30° Sweep				
1	4" x 6" Fernco				


DATE \_\_\_\_\_

TOWN OF LEXINGTON — BOARD OF PUBLIC WORKS

SEWER DIVISION

Sketch of Service Here

17

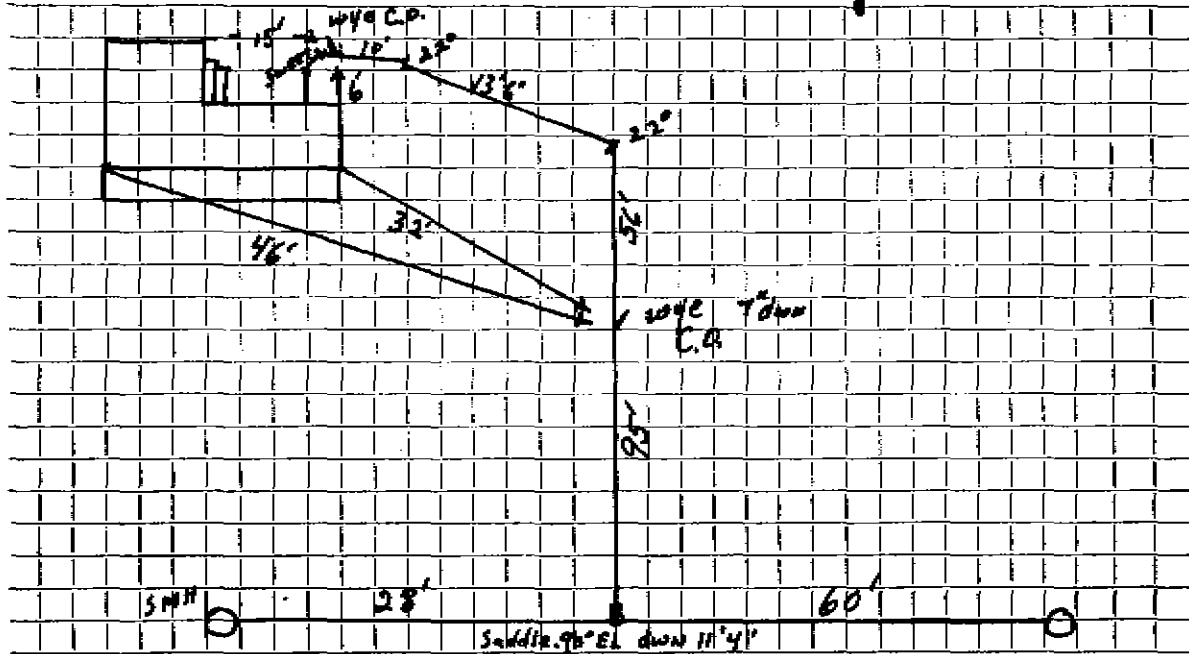

Connection made in ..... Street. Work completed .....

Remarks: .....

.....

.....