

Name **George Makechnie**

Service No. **201**

Address **#19 PERCY Road**

**19 Percy Road**

Location

Kind of Pipe

Size **6"**

Size of Main **8"**

~~REPLACEMENT~~ **New Service** *WO# 7742*

Location **Comm 7-25-63**


Date	Material	Amount	Total	Date	Amount
0-62	Labor	108.07		11-26-62	Deposit 300.00
	10% O.H.	10.81	118.88	3-25-63	Refund 49.12
	58' 6" Transite pipe @.82		47.56		250.88
	1 11 1/4° Transite Elbow		2.35		
	1 90° Transite Elbow		4.09		
	10 x 3 Patch		10.00		
	4 hrs. Town Shovel @6.50		26.00		
	3 hrs. Trucking @3.00		9.00		
	2 hrs. Compressor @5.00		10.00		
	1 hr. Trailer @3.00		3.00		
	Spring Loam & Seed		20.00		
			250.88		

DATE \_\_\_\_\_

TOWN OF LEXINGTON — BOARD OF PUBLIC WORKS  
SEWER DIVISION

Sketch of Service Here

19

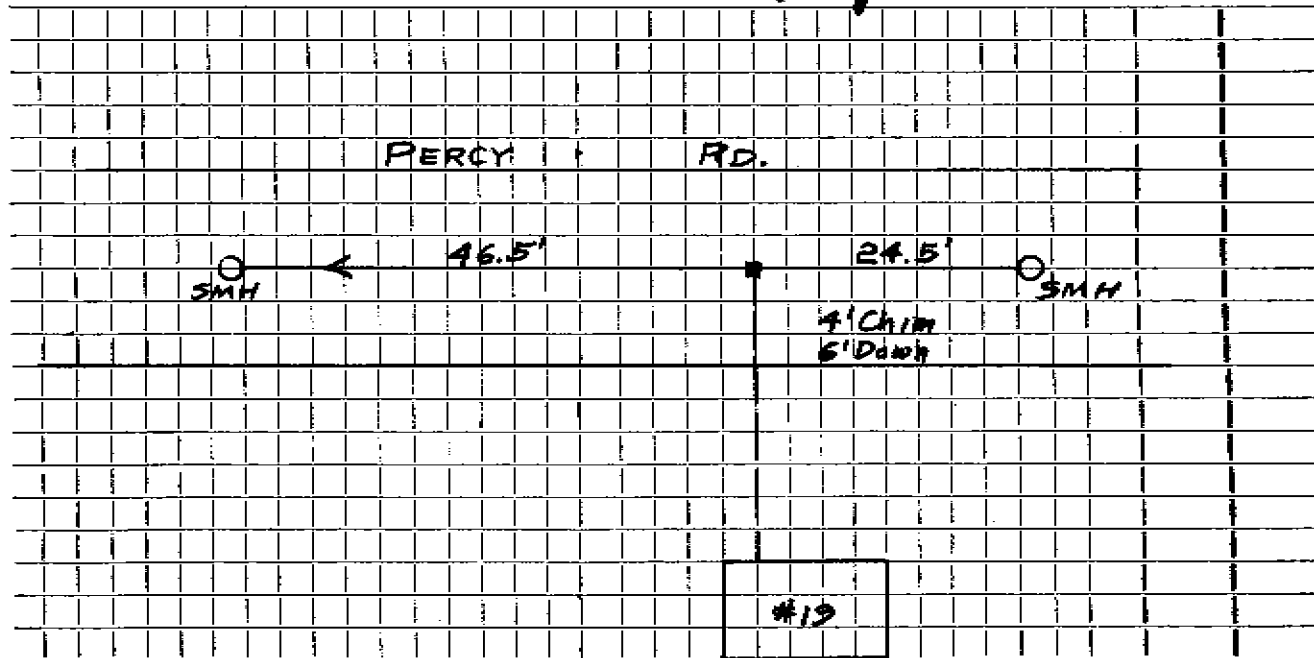

Connection made in ..... Street.

Work completed .....

Remarks: .....