

Name **Alice Howell**

Service No. **4**

Address #**20** **PERCY ROAD**

**20 Percy Road**

Location

Kind of Pipe

Size **6"**

Size of Main **8"**

Repair—Renewal—New Service **WO # 7793**


Location **Comm 4-22-63**

Date	Material	Amount	Total	Date	Amount
'63	Labor	100.59		12-12-62	350.00
1/63	"	43.38	143.97	4-22-63	85.88
	10% O.H.	14.40	158.37		264.12
56'	Transite Pipe @ .82		45.92		
1	6 X 8 Service Saddle		5.65		
1	90° Transite Elbow		4.09		
1	11 1/2° Transite Bend		4.09		
4	Hrs. Town Shovel @ 6.50		26.00		
4	Hrs. Trucking @ 3.00		12.00		
8	X 3 Patch		8.00		
			<u>264.12</u>		

DATE \_\_\_\_\_

TOWN OF LEXINGTON — BOARD OF PUBLIC WORKS  
SEWER DIVISION

Sketch of Service Here **20**

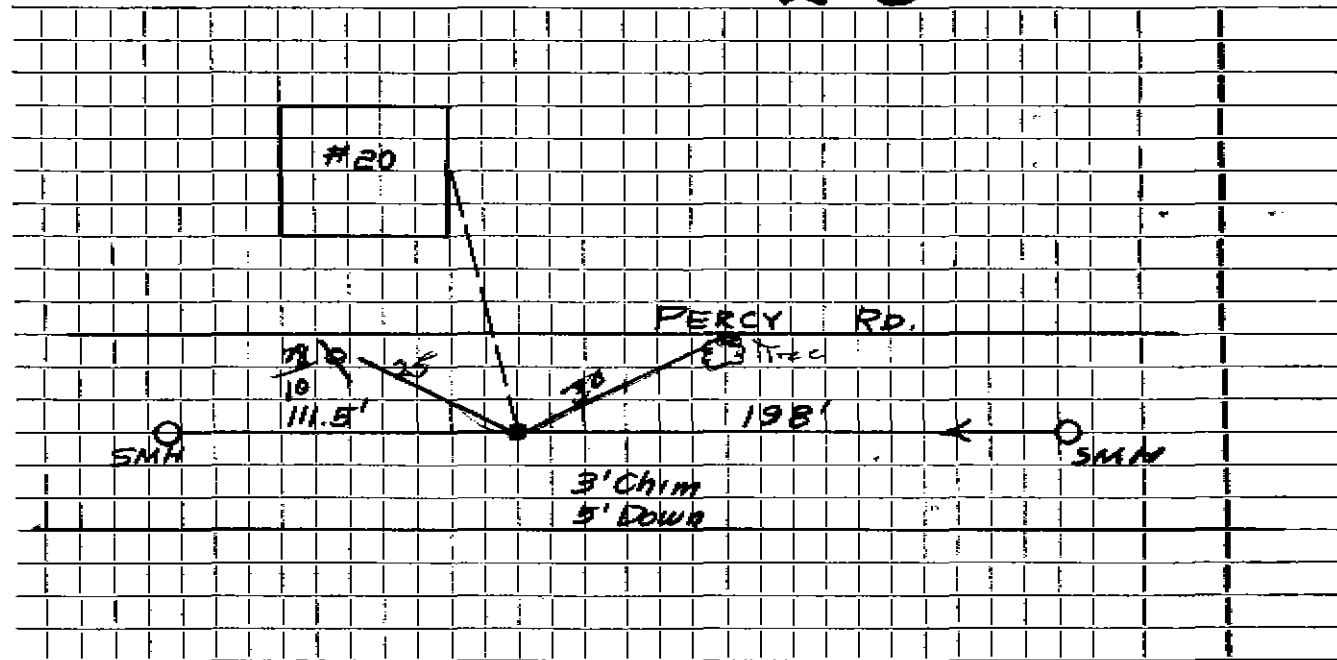

Connection made in ..... Street. Work completed .....

Remarks: .....

.....

.....

.....