

Name

Service No.

Address 21 PERCY ROAD

Vacant Lot

Location

Kind of Pipe

Size 6"

Size of Main 8"

Repair—Renewal—New Service


Location

Date	Material	Amount		Total		Date		Amount	

DATE _____

TOWN OF LEXINGTON — BOARD OF PUBLIC WORKS
SEWER DIVISION

Sketch of Service Here **21**

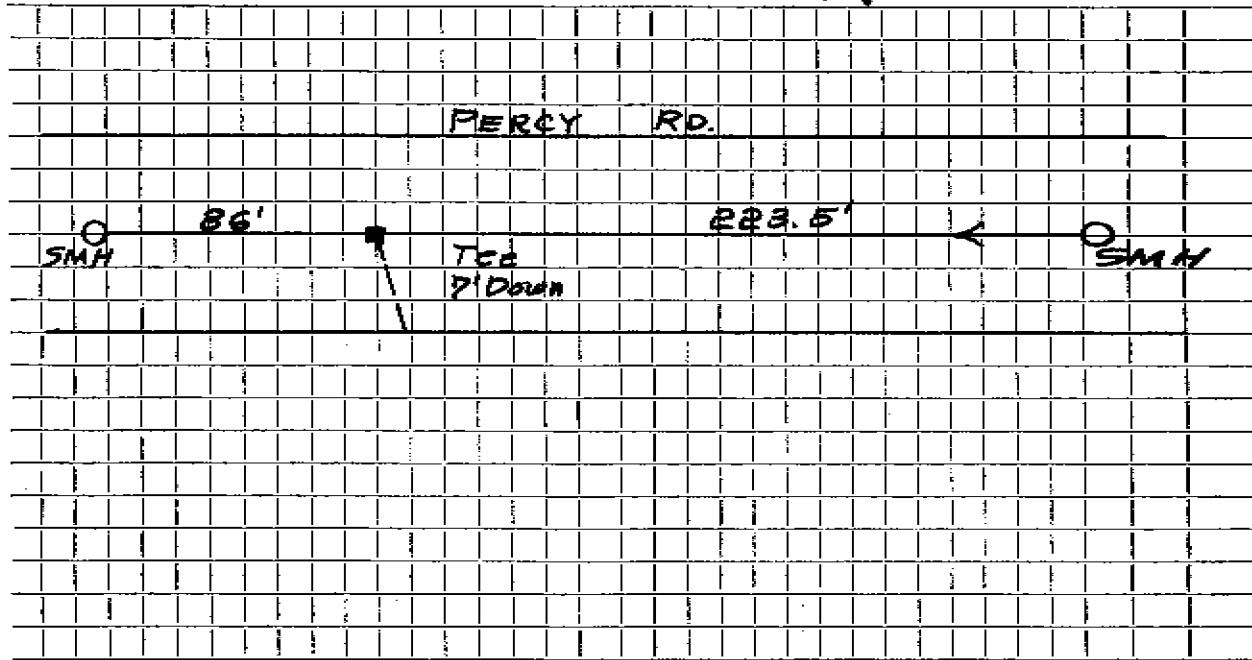

Connection made in Street. Work completed

Remarks:
.....
.....