

Name Donald Blackmer

Service No. 41

Address #24 PERCY ROAD

24 Percy Road

Location

Kind of Pipe

Size 6"

Size of Main 8"

~~Contract~~ — New Service W.O. # 6363 Lexington Sewerage #1359

Location JUL 7 1969


Date	Material	Amount	Total	Date	Amount
5/29/69	Labor	58 47		5-29-69	Deposit 235 00
5/5/69	"	21 50	79 97	7-7-69	Retained 71 74
	10% O.H.		8 00	5-29-69	153 36
	20' 3/4" Transite pipe .88		17 60	20' 6" Transite	
	1 90° Elbow		4 09	1 6"-90° Elbow	
	2 Ton hoist top 5.80		11 60	1 6"X8" Wye	
	2 Hrs. trucking 3.00		6 00		
	2 " " 1.50		3 00		
	2 " Shovel 6.50		13 00		
	1 " Compressor		5 00		
	1 " Roller		3 00		
	Trailer		2 00		
-29-69	40' 6" Transite pipe		153 26		
	10' 4" Cast Iron pipe				

DATE _____

TOWN OF LEXINGTON — BOARD OF PUBLIC WORKS
SEWER DIVISION

Sketch of Service Here

24

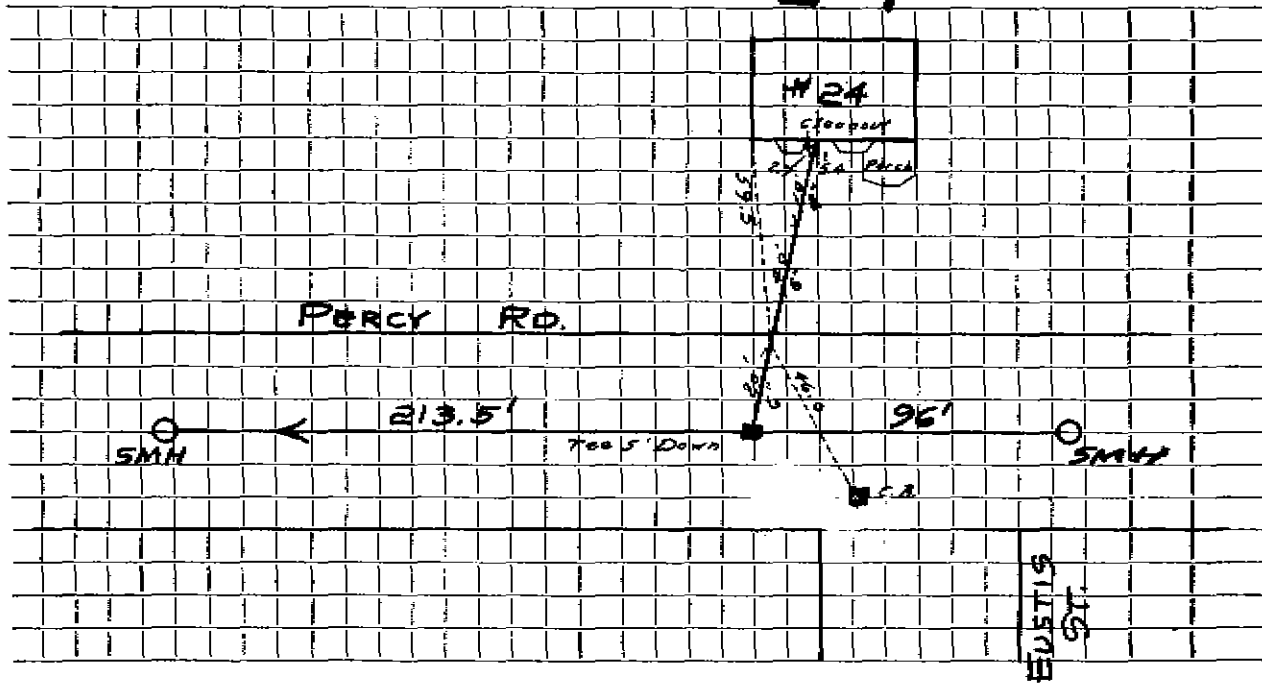

Connection made in Street. Work completed

Remarks:

.....

.....