

Name

Service No.

Address 31 Percy Road

31 Percy Road

Location

Kind of Pipe

Size 6"

Size of Main 8"

Repair - ~~Removal of Sewer~~

Location

Date		Material	Amount	Total	Date		Amount
					12/17/54	<u>NON CHARGE</u> Labor	25 25
						10' - 4" sewer pipe @ .32	3 20
						Joint compound	60
						5 hrs. Lt fld. Shovel @ 7.50	37 50
						2 hrs. Trucking @ .75	1 50
							68 05
		Labor					

TOWN OF LEXINGTON—DEPT. OF PUBLIC WORKS
SEWER DIVISION

DATE

NO.


The undersigned applies for the construction of a particular sewer connecting No.
Street and hereby agrees to comply with the Rules and Regulations governing the construction and use of Particular
Sewers, as now or at any future time established by the Board of Selectmen.

Am't of estimate \$.

Am't Paid \$.

..... Owner

Sketch of Service Here

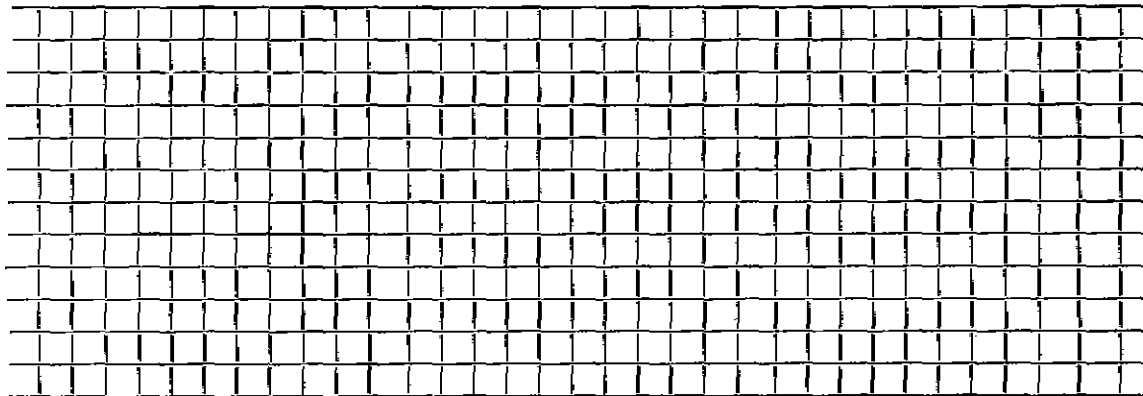

Connection made in Street.

Work completed 19..

Remarks: *Original Service 11-19-27 (45'-6" sewer pipe)*