

H. L. Titus

Service No. 812

Address 32 Percy Road, Lexington

32 Percy Road

Location

Kind of Pipe

Size 6"

Size of Main 8"

~~Ramp~~ - New Service

Location

Date 1941	Material	Amount	Total	Date	Amount	
July 7,	62 hrs. @ 50¢	31 00		June 10, 1941	Deposited	
<i>Sum 8/24/41</i>	95 " 60¢	57 00				100 00
	12 " 65¢	7 80	95 80			
	10% Overhead		9 58			
	60' 6" Sewer Pipe @ 16¢		9 60			
	10' 4" Iron Pipe @ 50¢		5 00			
	1 6" 1/8 Bend		65			
	Jointing compound		3 60			
	2 1/2 hrs. compressor @ 2.25		5 63			
	1 1/2 " tractor @ 1.25		1 88			
	4 hrs. trucking @ 75¢		3 00			
			134 74			
	labor CHARGE \$100.00					

**TOWN OF LEXINGTON—BOARD OF PUBLIC WORKS**  
**SEWER DIVISION**

DATE \_\_\_\_\_

NO. \_\_\_\_\_

The undersigned applies for the construction of a particular sewer connecting No. \_\_\_\_\_ Street and hereby agrees to comply with the Rules and Regulations governing the construction and use of Particular Sewers, as now or at any future time established by the Board of Selectmen.


Am't. of Estimate \$ \_\_\_\_\_

Am't. Paid \$ \_\_\_\_\_

\_\_\_\_\_  
Owner

Sketch of Service Here

**32**

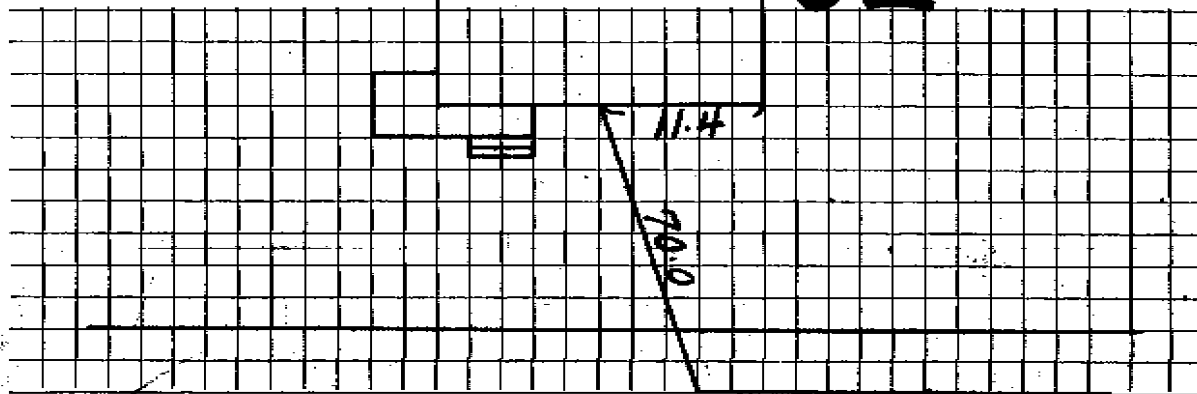

Connection made in \_\_\_\_\_ Street.

Work completed \_\_\_\_\_ 19

Remarks: