

Service No.

Name

Address

Location

36 Percy Road

Kind of Pipe

Size 6"

Size of Main 8"

Repair—Renewal—New Service

Location

Date	Material	Amount	Total	Date	Amount
11-16-27				12-1-27	12 50
53	4" Clay Pipe			12-10-27	19 43
2'	6" "				
2'	6" Beads				
1	6" x 4" Reducer				


6-15-60 Roto

DATE _____

TOWN OF LEXINGTON — BOARD OF PUBLIC WORKS

SEWER DIVISION

Sketch of Service Here

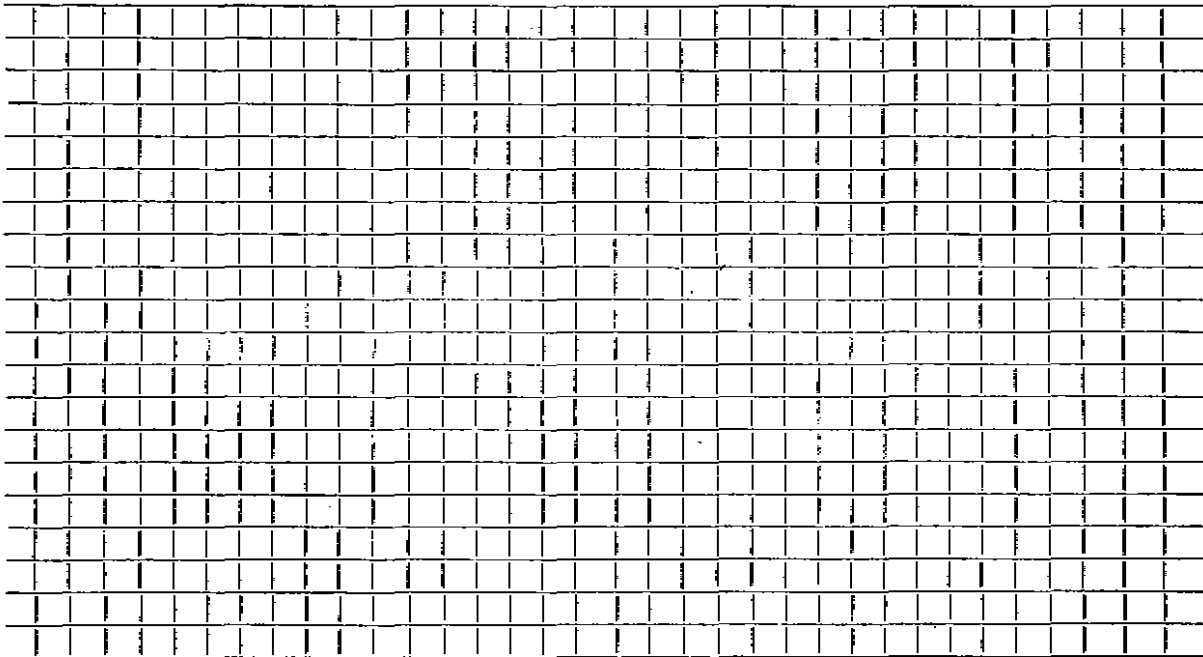

A large grid consisting of 20 columns and 25 rows, intended for a sketch of service details. The grid is empty and occupies the central portion of the page.

Connection made in Street. Work completed

Remarks:
.....
.....