

Mr. Harold T. Jones

Service No. 217

Address ~~87 Mill Street, Boston, Mass.~~

37 Percy Rd.

Location 37 Percy Road

Kind of Pipe

Size 6"

Size of Main 8"

Work - ~~General~~ - New Service

Location

Date 1939	Material	Amount	Total	Date	Amount
Apr. 14	15 hrs. @ 50¢	7 50		April 7, 1939	Deposited 110 00
Apr 15 1939	60 " @ 55¢	33 00		June 7, 1939	Paid 156 5
	43 1/2 " @ 60¢	26 10			(C) 10.65
	15 1/2 " @ 70¢	10 85	77 45		125 65
	10% Overhead		7 74		
	40' 6" Sewer Pipe @ 20¢		8 00		
	1 6" - 1/8 Bend		65		
	1 6" x 4" Reducer		1 00		
	1 bag cement		75		
	Jointing compound		2 40	Bill sent 5-11-39	
	6 hrs. Compressor @ 3.00		18 00		
	2 " Trucking @ 75¢		1 50		
	Trench Repairs		8 16		
			\$125.63		
	Box Charge - 15.00				

Hedley Press, Inc., Lexington

TOWN OF LEXINGTON—BOARD OF PUBLIC WORKS
SEWER DIVISION

DATE April 7 1939.

NO. _____


The undersigned applies for the construction of a particular sewer connecting No. 37 Lucy Road Street and hereby agrees to comply with the Rules and Regulations governing the construction and use of Particular Sewers, as now or at any future time established by the Board of Selectmen.

Am't. of Estimate \$ 110⁰⁰

Am't. Paid \$ _____

Dr. Irwin P. Caplan Owner
87 Milk St.

Sketch of Service Here **37** Boston

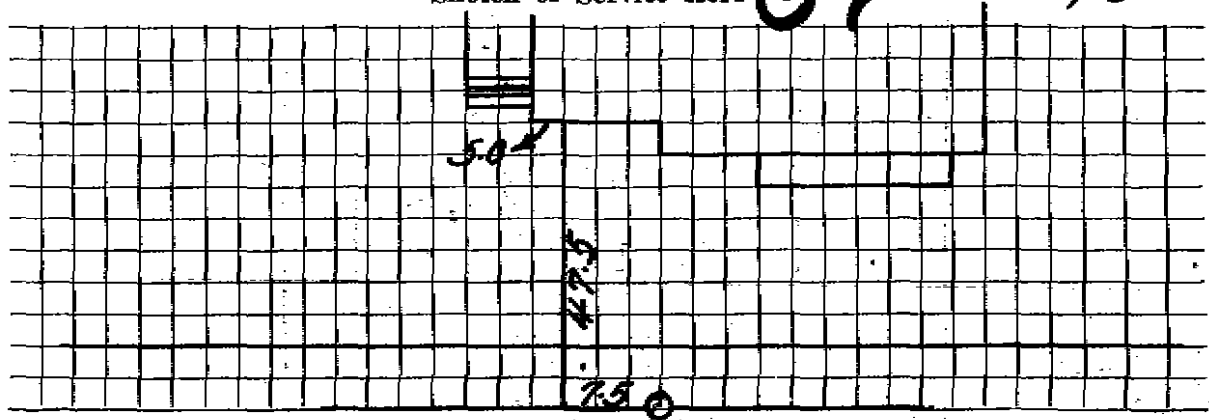

Connection made in _____ Street. Work completed _____ 10

Remarks: