

Name

Service No.

Address 4 Precy Rd

Location

Kind of Pipe

Size

Size of Main

Repair—Renewal—New Service


Location

Date	Material	Amount	Total	Date	Amount
Sept 27 98	135' 6" PVC	PVC			
	1-4x6 CI to PVC	Feencko			
	1-6x6 PVC to AC	Feencko			
	1-220 Bend				
	1-6x6x6 wye				
	1- M.H. Feencko cover				

DATE _____

TOWN OF LEXINGTON — BOARD OF PUBLIC WORKS
SEWER DIVISION

Sketch of Service Here

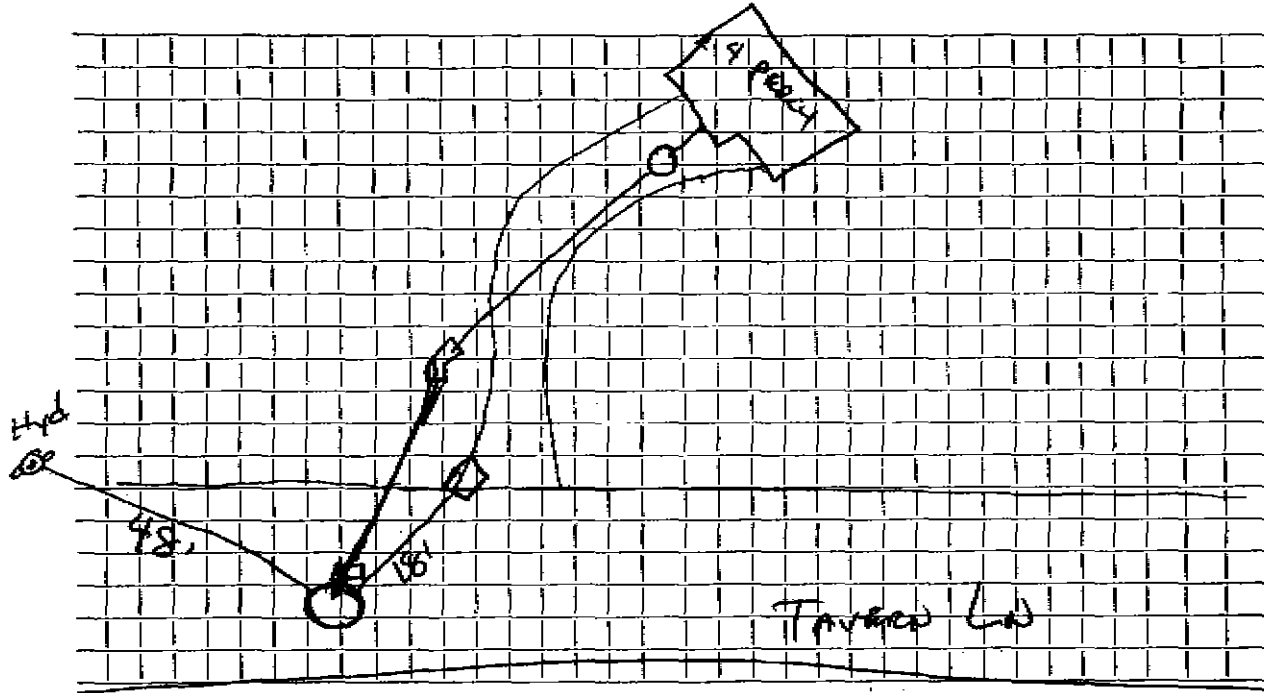

Connection made in _____ Street. Work completed _____

Remarks: SERVICE RENEWED FROM HOUSE TO M.H. ON
TAVERN LN.