

Name **Richard K. Eaton**

Service No. **109**

Address **40 Percy Road**

40 Percy Road

Location

Kind of Pipe

Size **6"**

Size of Main **8"**

~~RENEW~~—Renewal—~~XXXXXXXXXX~~

W.O. # **5702**


Location **FEB 10 1975**

Date	Material	Amount	Total	Date	Amount	
11-14-74	Labor	54 59		11-1-74	Deposit	400 00
11-15-74	Labor	81 94		3-18-75	Refund	82 97
11-18-74	Labor	34 78				317 23
		171 31			Non-Charge Work	
	10% O.H.	17 13	188 44	11-14-74	Labor	126 05
40'	6" Transite Pipe	1 24	49 60	11-15-74	Labor	81 94
1	11 1/2" El	3 94	3 94	20'	6" Transite Pipe	24 80
10'	Nipple w/coupling	1 60	16 00	1	6"x6" Nipple @ 1.24	1 76
1	O-Ring	3 05	3 05	1	90° El	5 63
1	Yd. Loam	5 00	5 00	1/2	Bag Cement	1 10
15	Lbs. Grass seed	95	14 25	1	Ten Cold Patch	12 20
1 1/2	Hrs. Trucking	3 00	13 50	2	Yds. Loam @ 5.00	10 00
2	Hrs. Trucking	1 50	3 00	5	Lbs. Seed @ .95	4 75
2 1/2	Hrs. Town Shovel	6 50	16 25	2 1/2	Hrs. Trucking @ 3.00	7 50
2	Hrs. Roller	2 00	5 00	2	Hrs. Trucking @ 1.50	3 00
				1 1/2	Hrs. Town Shovel @ 6.50	29 25
				1	Hr. Loader @ 4.00	4 00
				1	Patch 1 1/2' x 4'	53 28
			8317 03	102079	Solids 8' x 10' 10'	365 25

DATE _____

TOWN OF LEXINGTON — BOARD OF PUBLIC WORKS
SEWER DIVISION

Sketch of Service Here **40**

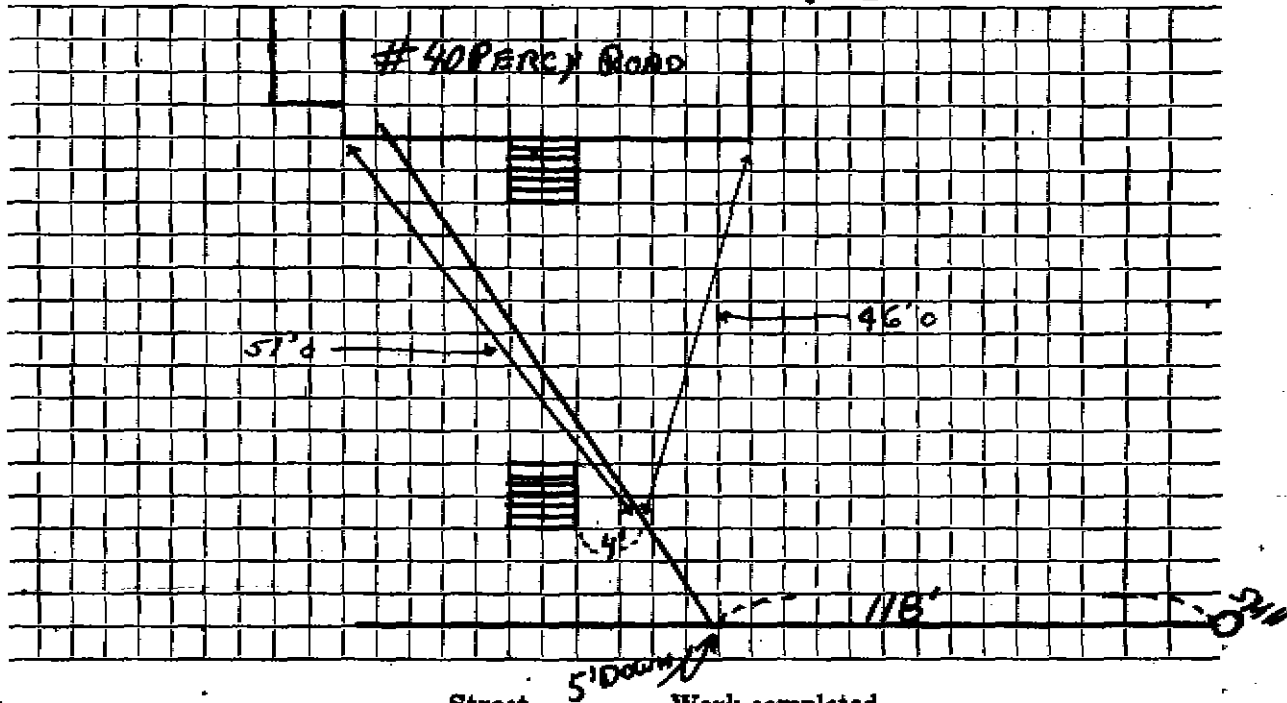

Connection made in Street. *5' DOWN* Work completed

Remarks:
.....
.....