

Wm O. Theakill

Address 167 Hillside Ave., Arlington 41 - Percy Rd.

41 Percy Road

Location 41 Percy Road

Kind of Pipe

Size 6"

Size of Main 8"

Repair—Renewal—New Service

Location

Date 1941	Material	Amount	Total	Date	Amount
Sept. 3	61 hrs. @ 60¢	36 60		August 5, 1941 Deposited	100 00
Sept 10/12/41	23 " @ 65¢	14 95		Oct 21, 1941 Refund	15 73
	8 " @ 70¢	5 60	✓ 57 15		84 27
	10% Overhead		✓ 5 71		
	50' 6" Sewer Pipe @ 16¢		✓ 8 00		
	Jointing compound		✓ 3 00		
	Compressor, 1 hr.		✓ 2 25		
	Trucking, 2 hrs. @ 75¢		✓ 1 50		
	Trench repairs		6 66		
			84 27		
	Labor				

Hadley Press, Inc., Lexington

TOWN OF LEXINGTON—BOARD OF PUBLIC WORKS

SEWER DIVISION

DATE

July 29, 1941

NO. \_\_\_\_\_

The undersigned applies for the construction of a particular sewer connecting No. 41 Percy Road Street and hereby agrees to comply with the Rules and Regulations governing the construction and use of Particular Sewers, as now or at any future time established by the Board of Selectmen.

Am't. of Estimate \$

100.00 Trench dig  
60.00 Down


Am't. Paid \$ \_\_\_\_\_

Carolyn D. Ide

Owner

Sketch of Service Here

**41**

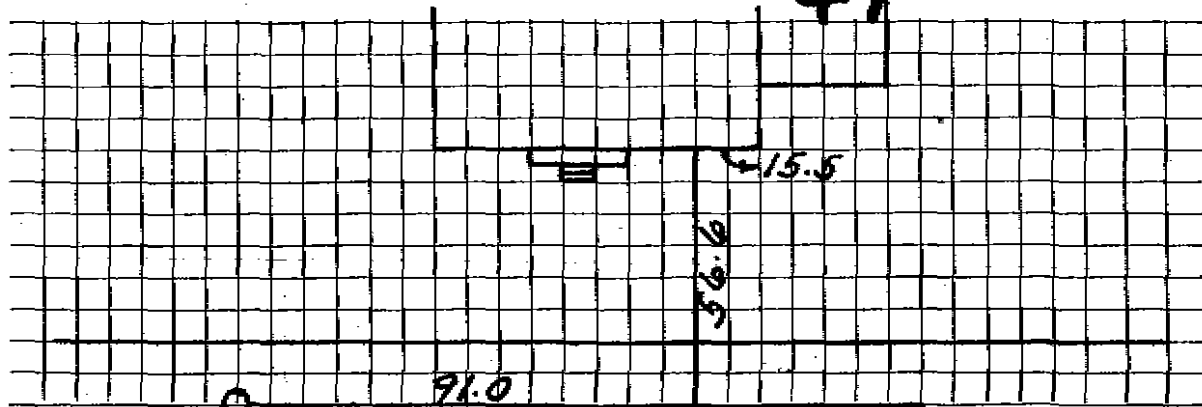

Connection made in \_\_\_\_\_

Street.

Work completed \_\_\_\_\_

19

Remarks: