

Name Fred Joy Fox

Service No. 235

Address 42 Percy Road

42 Percy Road

Location

Kind of Pipe

Size 6"

Size of Main 8"

~~Capitol Building~~ New Service Lexington Sewerage Permit #A-1146 W.O.#1386

Location

MAY 2 1966

Date	Material	Amount	Total	Date	Amount
10-65	Labor	89 12		11-14-65	100 00
	10% O.H.	8 91	98 03	6-10-66	70 71
	20' 6" Transite pipe @ 182		16 40	12-10-65	170 71
	1 6" Bend		4 09	20' 6" Transite	
	1 6" Elbow		4 09	1 6" Bend	
	1 1 1/2" Coupling		2 35	1 6" Elbow	
	15 x 3 Patch		15 00	1 6"-1 1/4" Coupling	
	3 1/2 Hrs. Tractor @ 6.50		22 75		
	1 Hr. Compressor		5 00		
	1 Hr. Truck		3 00		
			170 71		
-65	44' 6" Transite pipe				

Bill sent 70 71


DATE _____

TOWN OF LEXINGTON — BOARD OF PUBLIC WORKS

SEWER DIVISION

Sketch of Service Here

42

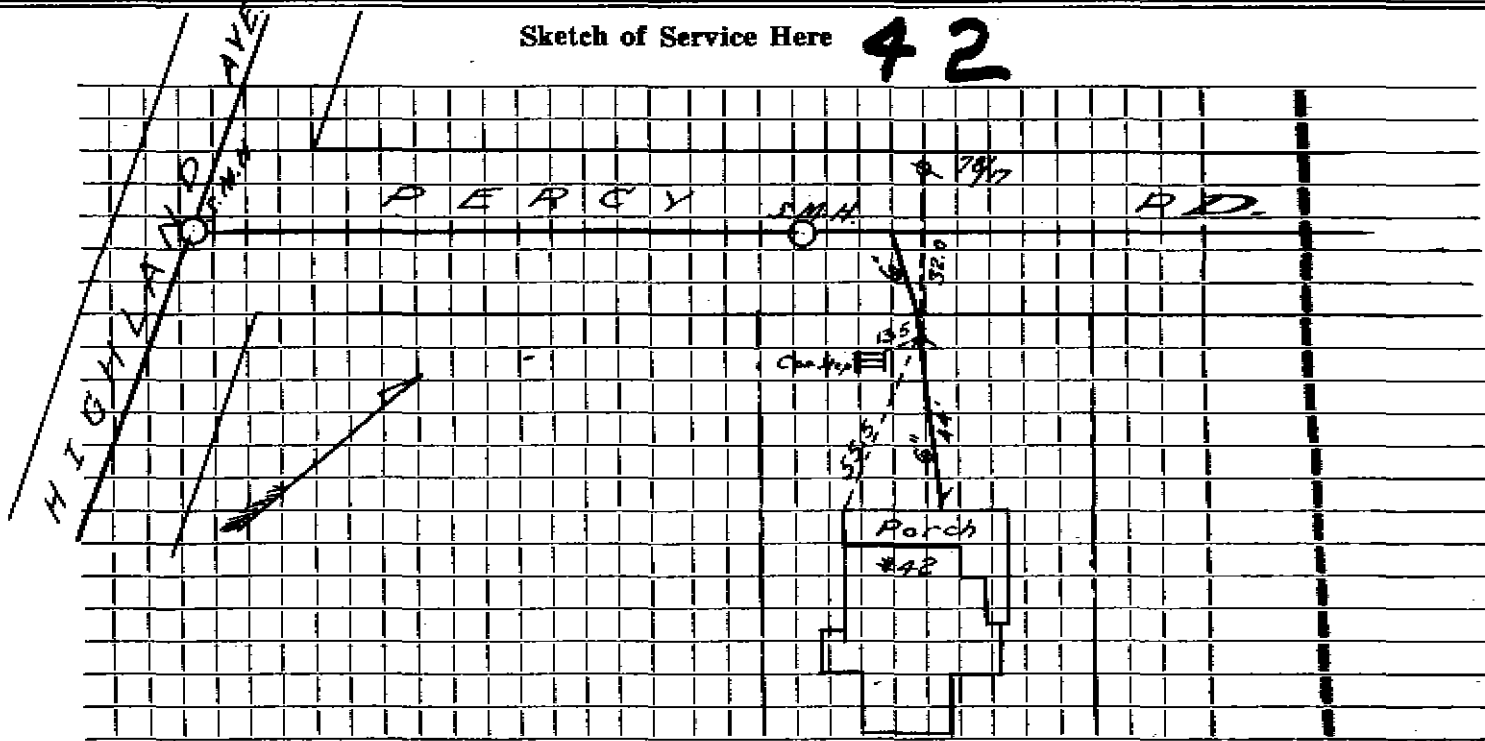

Connection made in Street. Work completed

Remarks:
.....
.....