


SEWER DIVISION

TOWN OF LEXINGTON — BOARD OF PUBLIC WORKS

DATE 9-12-'90

Sketch of Service Here

6

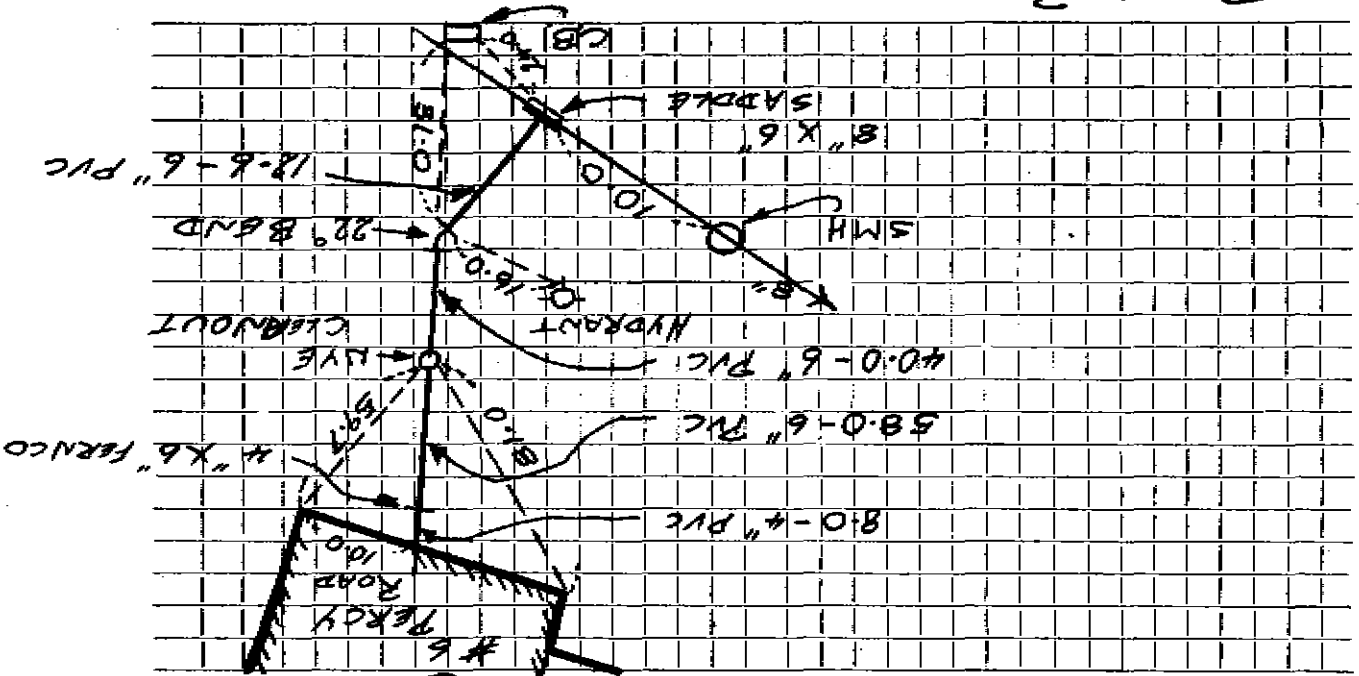

Work completed

Street

Percy Road

Connection made in

Remarks: