

Name R.K. Schmidt

Address # 15 Pheasant Lane

15 Pheasant Lane

Location

Kind of Pipe Size 6" ACP Size of Main 8" ACP
Repair—Renewal—New Service Lucente # 2249 Location Lot # 8


| Date | Material | Amount | Total | Date | Amount |
|--------|---------------|--------|-------|-----------------|--------|
| 5-1-68 | 32' 6" ACP | | | 5-1-68 | |
| 1-25 | 73 36' 6" ACP | | | 32' 6" Transite | |
| | 10' 4" CI | | | 1 6" X 8" Wye | |

DATE

TOWN OF LEXINGTON — BOARD OF PUBLIC WORKS
SEWER DIVISION

Sketch of Service Here

15

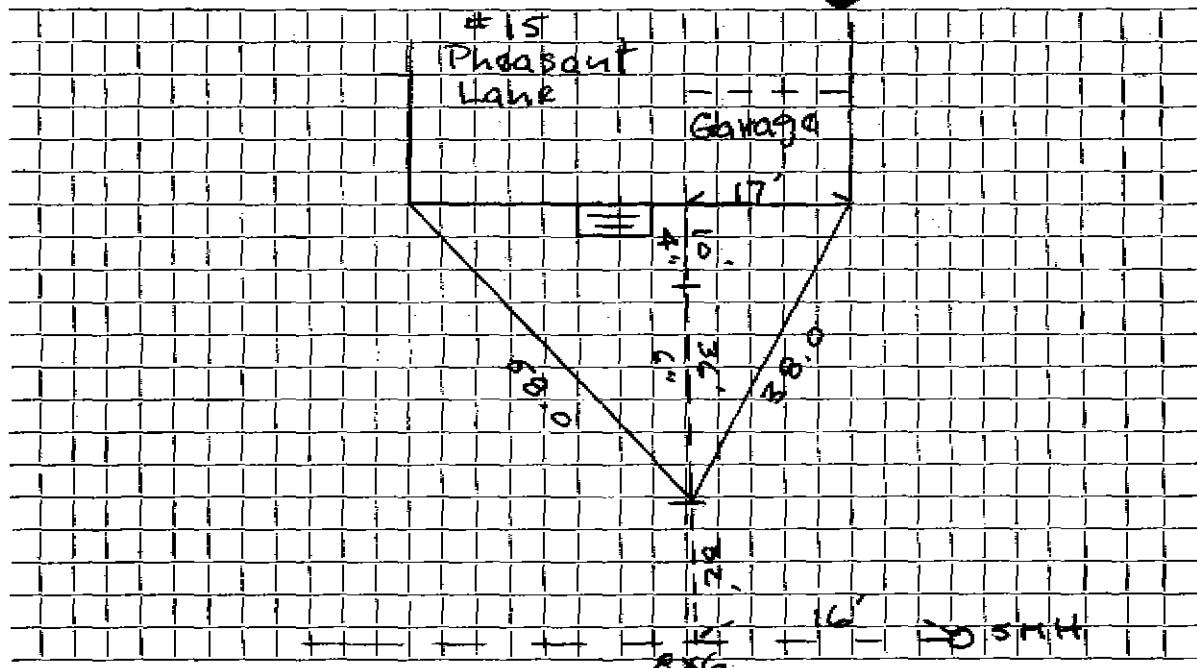

Connection made in Street. Work completed

Remarks: