



In the event this service works  
we trust forces should free it,  
measure the obstructions and make  
Recommendations.


D.S. 10/7/80

DATE \_\_\_\_\_

TOWN OF LEXINGTON — BOARD OF PUBLIC WORKS

SEWER DIVISION

16 Sketch of Service Here

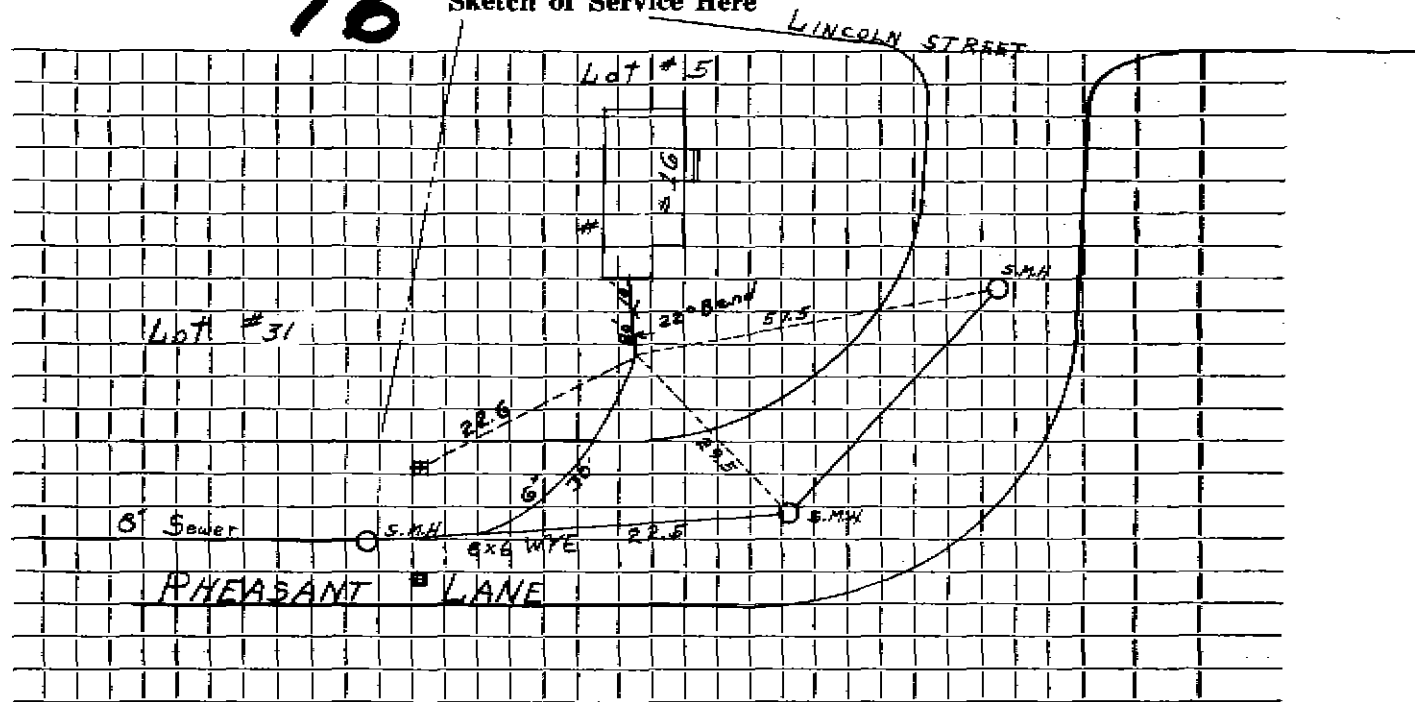

Connection made in ..... Street. Work completed .....

Remarks: .....

.....

.....