


DATE _____

TOWN OF LEXINGTON — BOARD OF PUBLIC WORKS
SEWER DIVISION

Sketch of Service Here

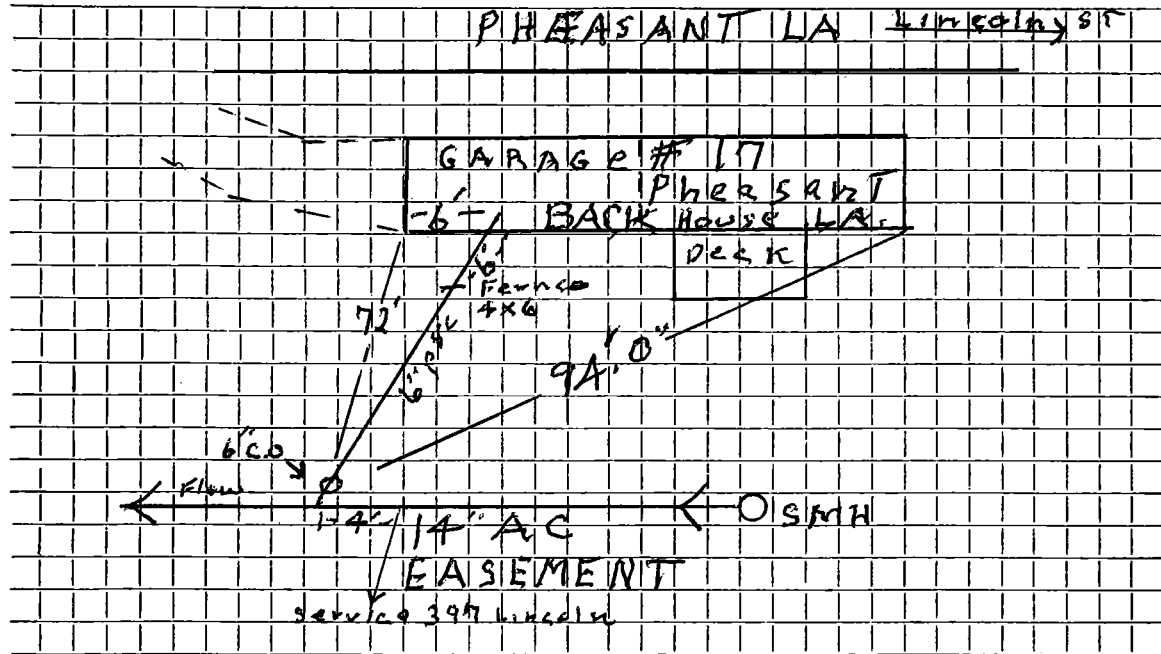

Connection made in Easement Street. Work completed July 1996 J. McClure

Remarks:

.....

.....