

Name

Service No. 2683

Address

8 Pheasant LA

Location

LOT 133

Kind of Pipe

Size

Size of Main

Repair—Renewal—New Service

J. McLaughlin

Location

Date

Material

Amount

Total

Date


Amount

Date	Material	Amount	Total	Date	Amount
6/11/68	22' 6" Transite				
	1 8"x6" Wye				
11/20/07	6' 4" sch 40 PVC				
	32' 6" PVC				
	1 4x6 Fernco				
	1 6" PVEX-AC Fernco	DOWN 9'			

DATE _____

TOWN OF LEXINGTON — BOARD OF PUBLIC WORKS
SEWER DIVISION

Sketch of Service Here

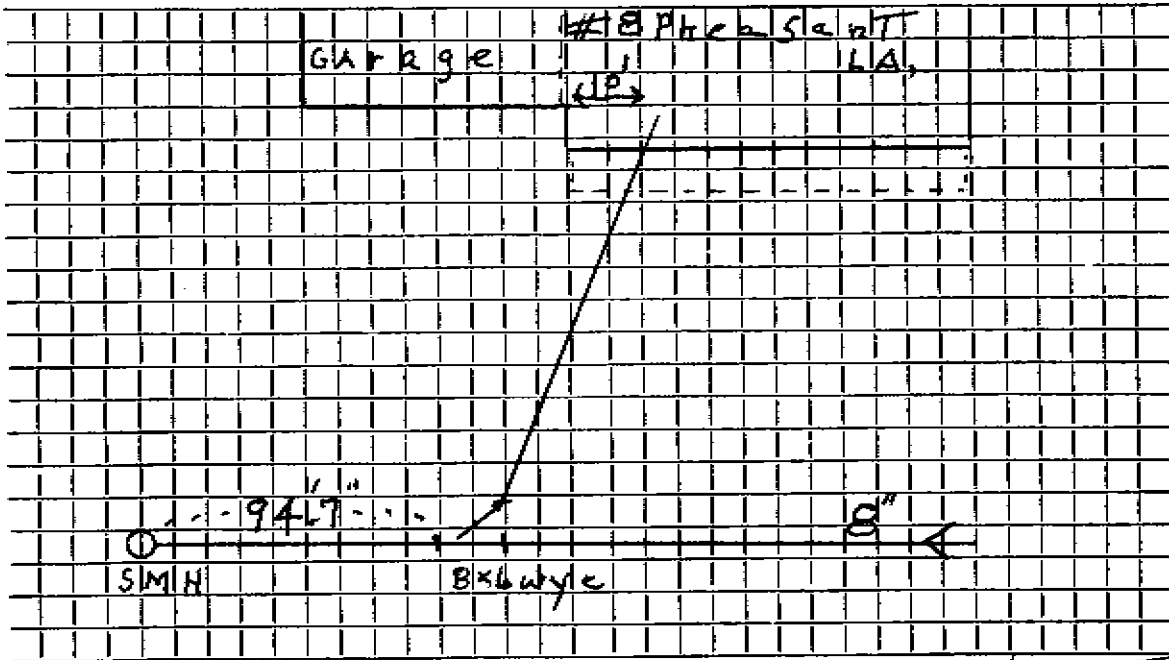

Connection made in Pheasant LA Street. Work completed 11/20/07 Jimcl

Remarks:

.....

.....