


DATE _____

TOWN OF LEXINGTON — BOARD OF PUBLIC WORKS
SEWER DIVISION

Sketch of Service Here

2

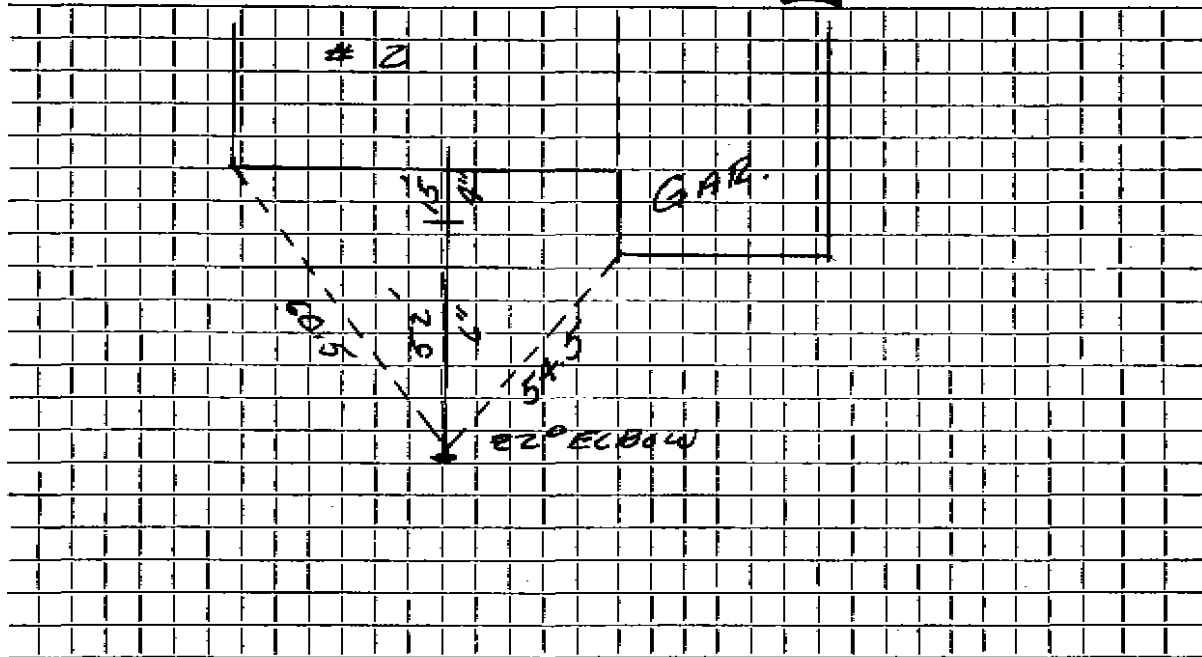

Connection made in PHILBROOK TERRACE Street. Work completed

Remarks: NO OUTSIDE TIES - 5' U. D. I. U. S. I. D. I.