


DATE _____

TOWN OF LEXINGTON — BOARD OF PUBLIC WORKS

SEWER DIVISION

Sketch of Service Here **3**

LOT #6

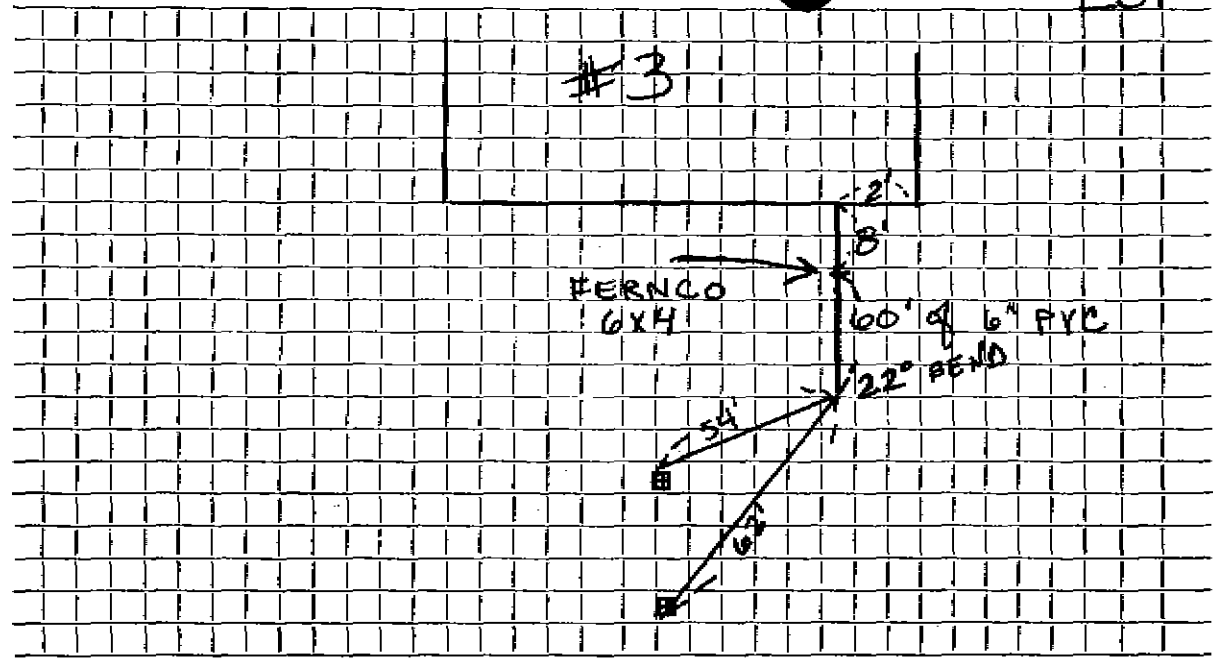

Connection made in PHILBROOK TERR. Street.

Work completed

Remarks: NOTE: NO OUTSIDE TIES

.....
.....