

Service No.

Name Robert Phelan

Address 4 Fairbrook Terrace

4 Philbrook Terrace

Location

Kind of Pipe PVC

Size 4" x 4"

Size of Main 8"

Repair—Renewal—New Service

Redmond 14960

Location

| Date | Material | Amount | Total | Date | Amount |
|----------|----------------|--------|-------|------|--------|
| 10/20/87 | 76 LF 4" PVC | | | | |
| | 10 LF 4" PVC | | | | |
| | 6" 22° ELBOW | | | | |
| | 4" x 6" FERRUG | | | | |
| | | | | | |
| | | | | | |

TOWN OF LEXINGTON — BOARD OF PUBLIC WORKS

SEWER DIVISION

DATE _____

Sketch of Service Here

4

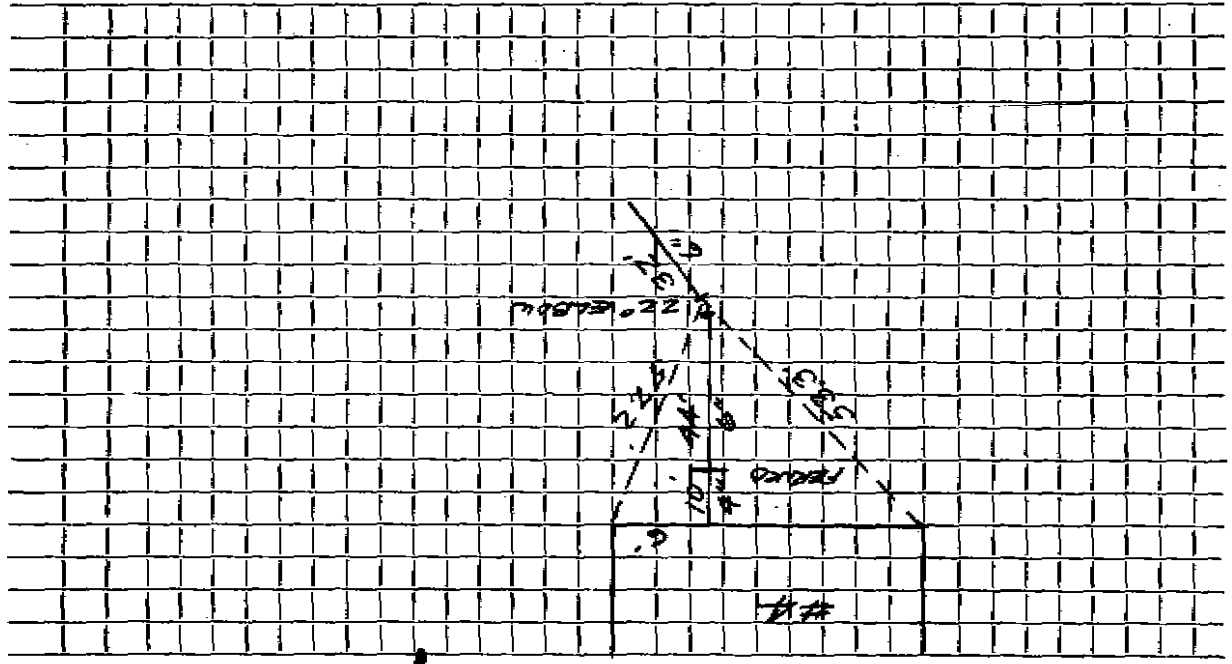

Work completed

Street

Connection made in Fall Brook Terrace

Remarks: No outside ties
Subdivision