

Name: Robert Frazier

Service No.

adj

Address: 6 Philbrook Terrace

6 Philbrook Terrace

Location

Kind of Pipe: PVC

Size: 6"

Size of Main: 8"

Repair: Renewal - New Service Redmond #4650

Location


Date	Material	Amount	Total	Date	Amount
7/13/68	① 6" PVC. 22 1/2' band 39 ft. 6" PVC.				
	① 6x4 fence.				
	10 ft. 4" PVC.				

TOWN OF LEXINGTON — BOARD OF PUBLIC WORKS

SEWER DIVISION

DATE _____

Sketch of Service Here
6

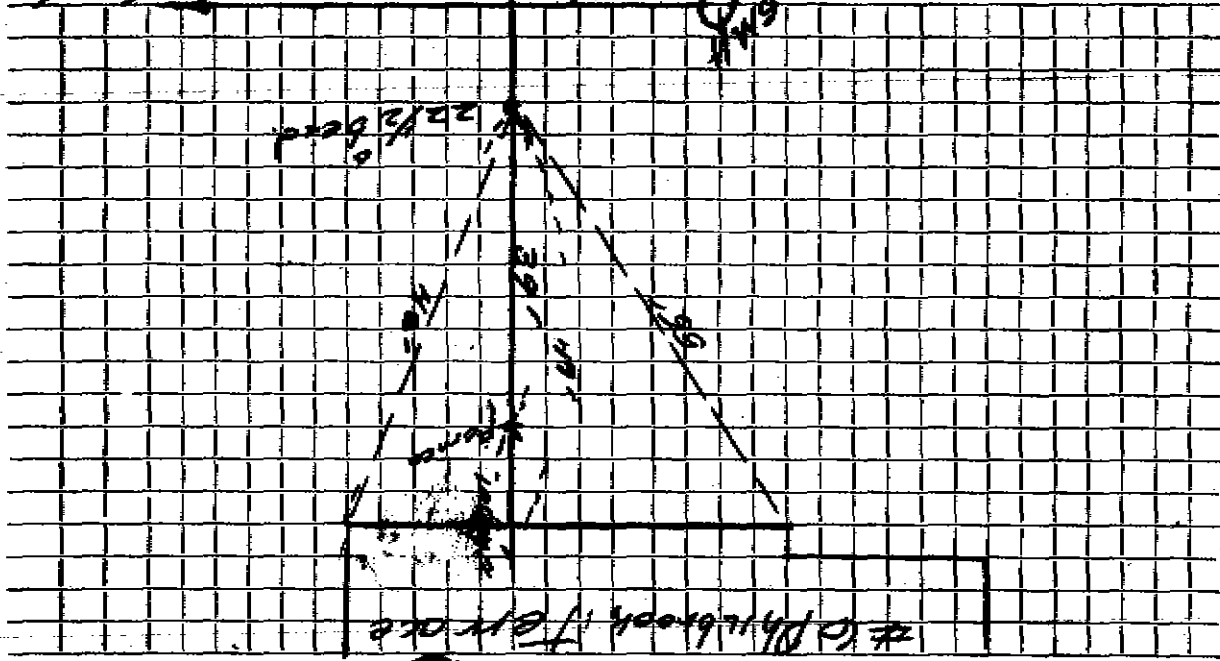

Work completed

Street

NO TIES OUTSIDE

NOTE: NO TIES OUTSIDE

CONNECTION MADE IN PHILBROOK TERRACE

Remarks: