


DATE _____

TOWN OF LEXINGTON — BOARD OF PUBLIC WORKS
SEWER DIVISION

Sketch of Service Here

7

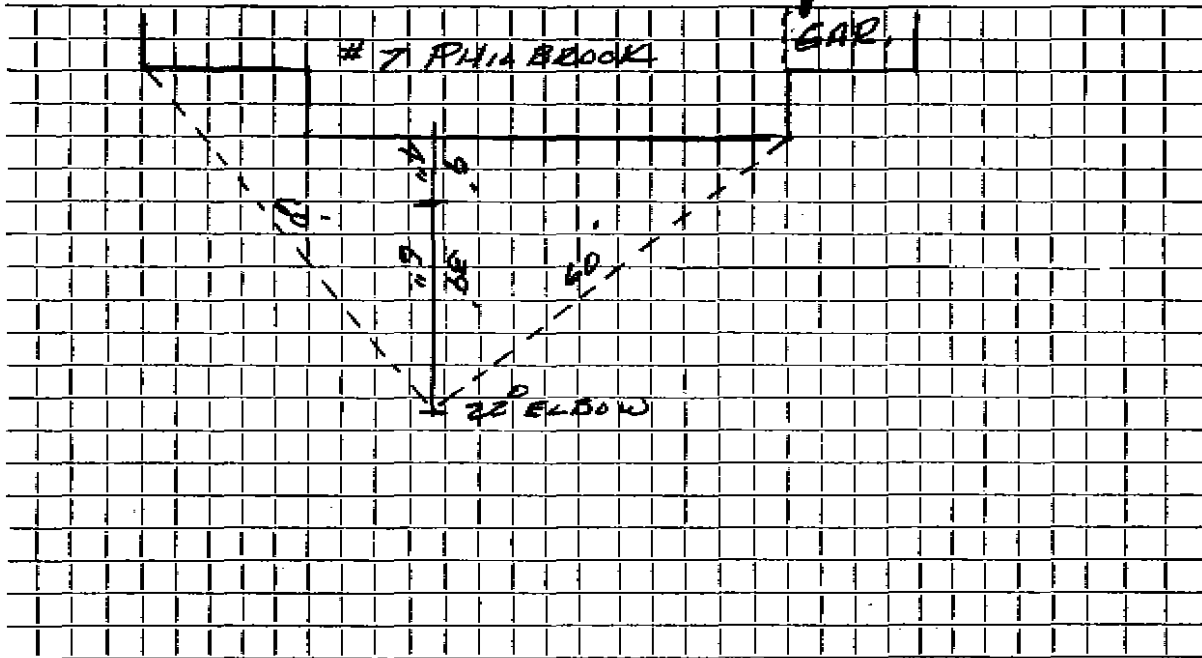

Connection made in PHILBROOK TERRACE Street. Work completed

Remarks: NO OUTSIDE TIES.
Subdivision 7