


DATE 10/2017

TOWN OF LEXINGTON — BOARD OF PUBLIC WORKS
SEWER DIVISION

Sketch of Service Here

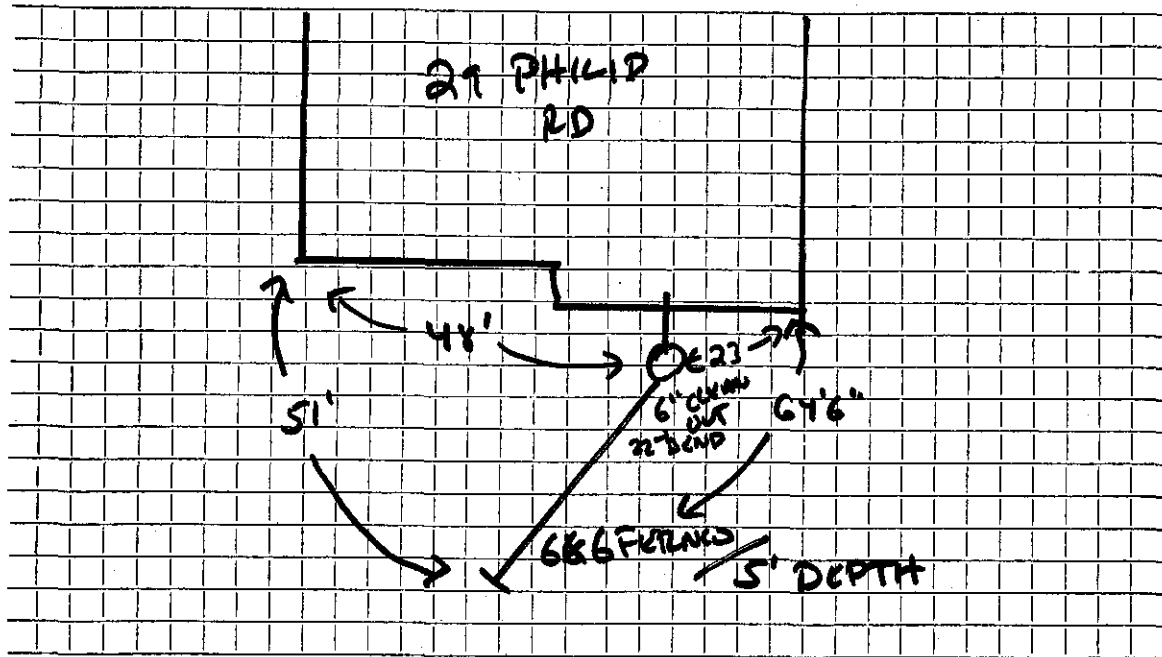

Connection made in PHILIP Street. Work completed LAKESIDE EXCAVATION

Remarks:

.....

.....