

Name Duffy Bros.

Service No.

Address 27 Philip Road

Lot #232 27 Philip Rd.

Location

Kind of Pipe

Size 6"

Size of Main 8"

Repair — ~~Renewal~~ — New Service Bonnano #A329

Location


Date	Material	Amount	Total	Date	Amount
2/21/66	55' 6" Transite pipe				

DATE _____

TOWN OF LEXINGTON — BOARD OF PUBLIC WORKS

SEWER DIVISION

Sketch of Service Here **27**

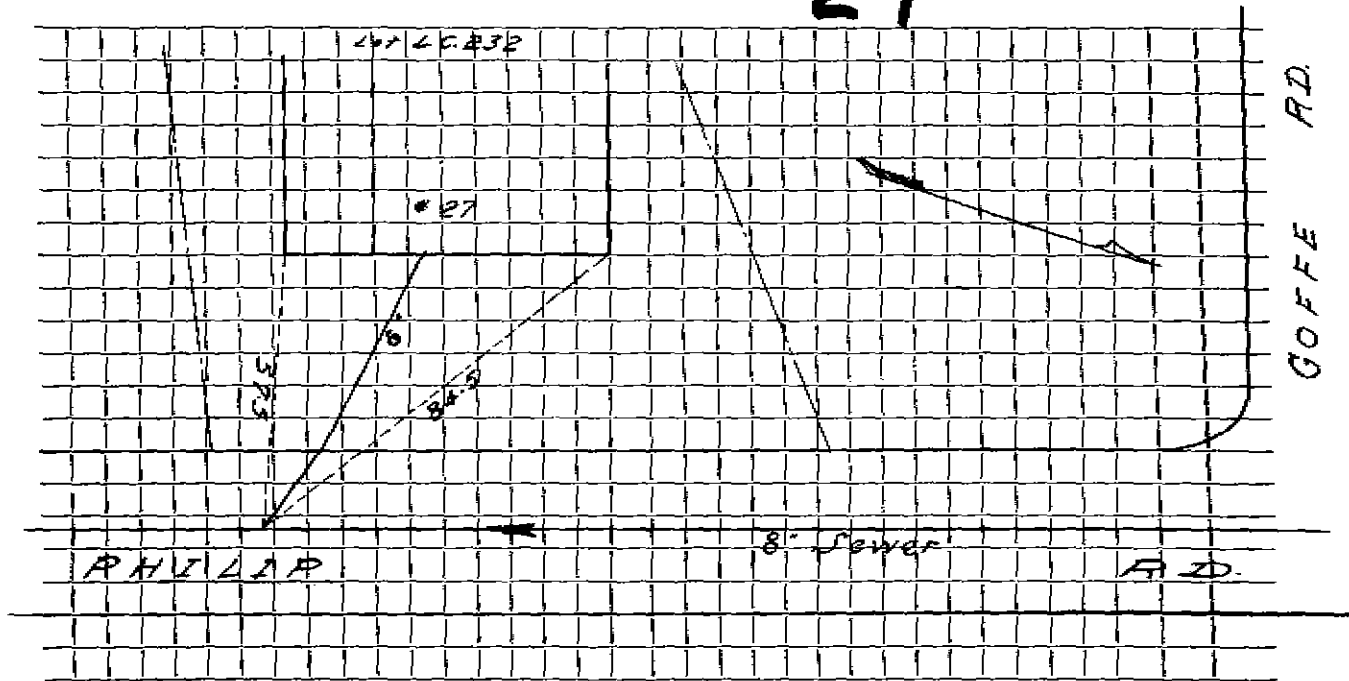

Connection made in Street. Work completed

Remarks:

.....

.....