

Name **Duffy Bros.**

Service No.

Address ~~DONIGER ROAD~~ 30 Philip Road

30 Philip Road

Location

Kind of Pipe

Size 6"

Size of Main 8"

~~REPLACE EXISTING~~ New Service Nick Bonanno Permit #A325

Location

Date		Material	Amount	Total	Date		Amount
-66	35'	6" Transite pipe					
/66	35'	6" Transite pipe					


DATE _____

TOWN OF LEXINGTON — BOARD OF PUBLIC WORKS

SEWER DIVISION

Sketch of Service Here

30

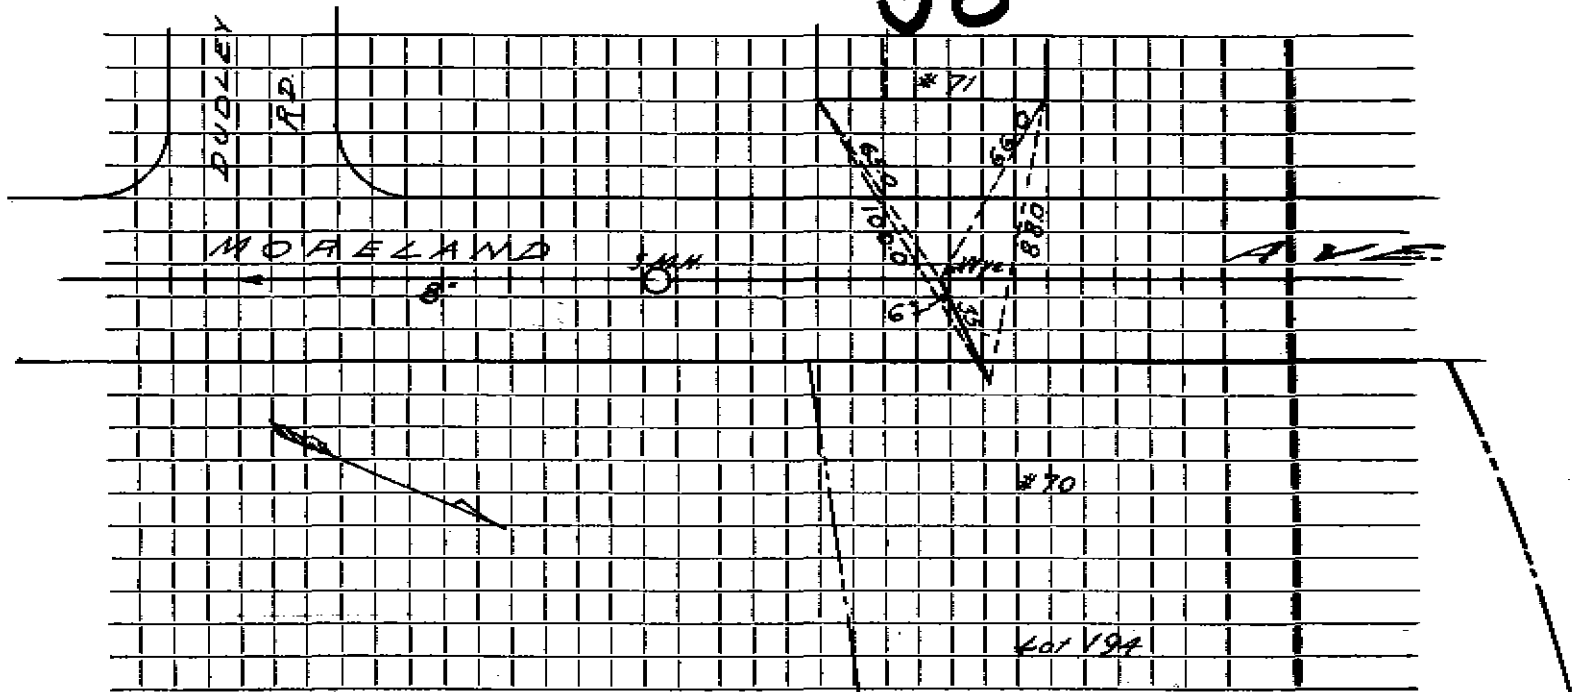

Connection made in Street. Work completed

Remarks:
.....
.....