

Name Minutes Man Estates

Service No.

Address ~~XXXXXXXXXXXXXXXXXXXX~~ 31 Philip Road

31 Philip Road

Location

Kind of Pipe

Size 6"

Size of Main 8"

~~XXXXXXXXXXXXXXXXXXXX~~ New Service Nick Bonanno Permit #A290


Location

Date	Length	Material	Amount	Total	Date	Amount
1-66	63'	6" Transit pipe				

DATE _____

TOWN OF LEXINGTON — BOARD OF PUBLIC WORKS
SEWER DIVISION

Sketch of Service Here **31**

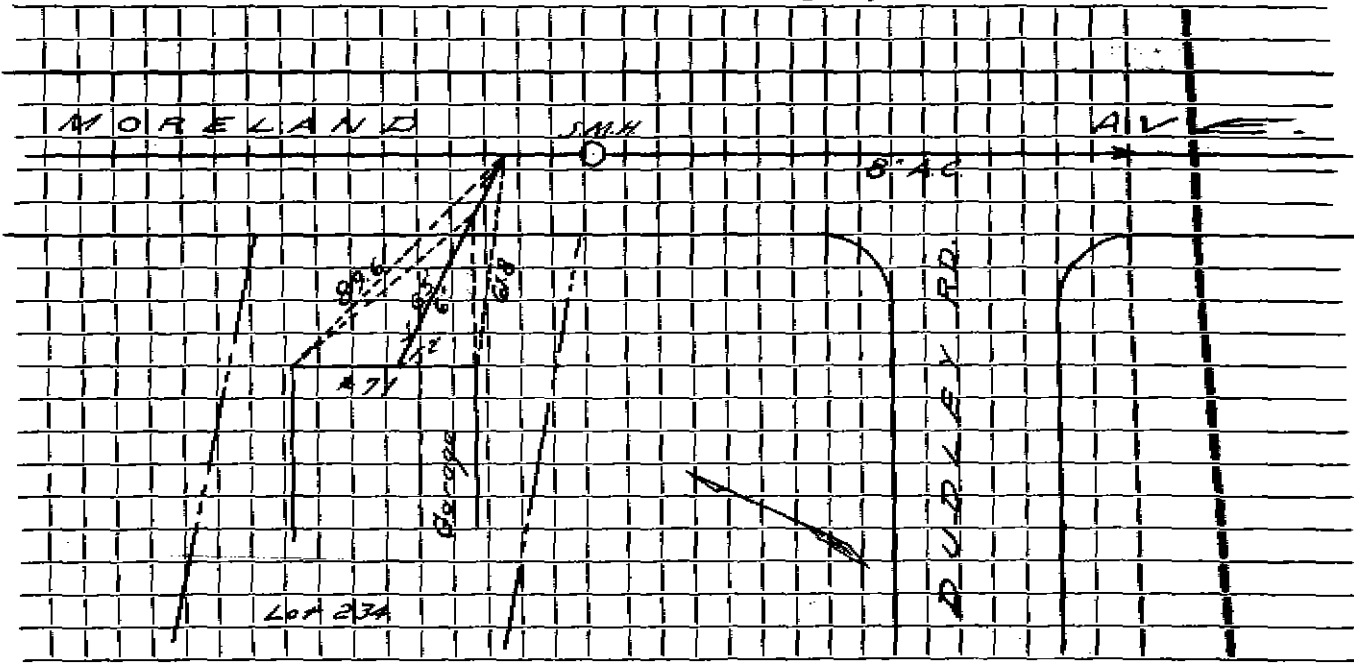

Connection made in Street. Work completed

Remarks:
.....
.....