

Name Minute Man Estates

Service No.

Address ~~YACONIA ROAD~~ 33 Philip Road

Lot #235 33 Philip Road Location

Kind of Pipe John J. Flannery #A83
Nick Bonanno

Size 6"

Size of Main 8"

~~Reason for Work~~ New Service Permit #A241


Location

Date	Material	Amount	Total	Date	Amount
10/65	27.6'	6" Transite pipe			
		(Flannery)			
5/66	43'	6" Transite pipe			
		(Bonanno)			
				11-18-65	
				27.6'	6" Transite
				1	6" x 8" Wye

DATE _____

TOWN OF LEXINGTON — BOARD OF PUBLIC WORKS
SEWER DIVISION

Sketch of Service Here **33**

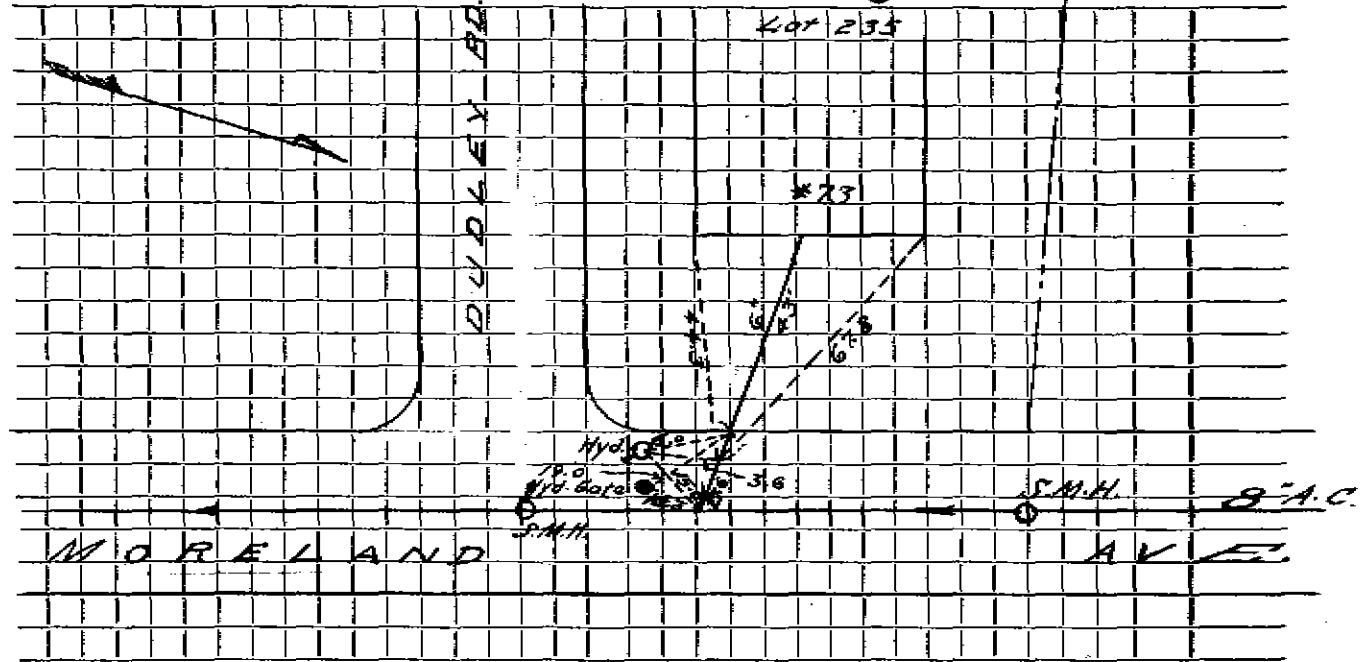

Connection made in Street. Work completed

Remarks:
.....
.....