




DATE 9/29/22

TOWN OF LEXINGTON — BOARD OF PUBLIC WORKS  
SEWER DIVISION

Sketch of Service Here

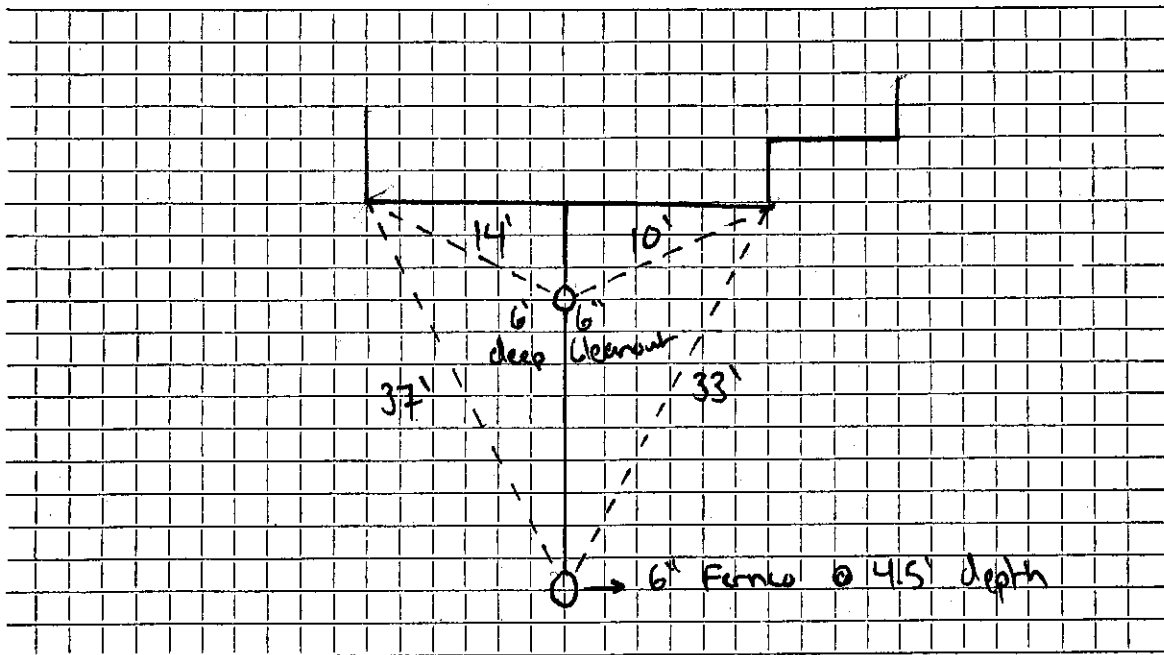

Connection made in ..... Street. Work completed .....

Remarks: INSTALLED By SPEEDWAGON PARTNERS .....